

Laundes  
G 2043

MISSISSIPPI  
BOARD OF WATER COMMISSIONERS  
416 North State Street  
Jackson, Mississippi 39201

10-18-79

WATER WELL DRILLERS LOG

Oct 18 1979 date well completed  
19 Mid South Drilling firm name  
Laundes county well located

LANDOWNER: <u>G. C. More</u>	description of formations encountered	from	to
<u>Columbus, MS 39701</u> (mailing address)	<u>clay</u>	<u>0</u>	<u>10</u>
	<u>sand &amp; gravel</u>	<u>10</u>	<u>30</u>
WELL LOCATION: sec <u>26</u> T <u>18</u> S R <u>18</u> E <u>1 1/2</u> miles <u>S</u> of <u>Columbus</u> (distance) (direction) (nearest town)	<u>clay &amp; sand</u>	<u>30</u>	<u>45</u>
	<u>clay</u>	<u>60</u>	<u>90</u>
WELL PURPOSE: <u>home</u> (home, irrigation, municipal, industrial)	<u>clay &amp; sand</u>	<u>90</u>	<u>180</u>

- WELL COMPLETION DATA:
- (1) diameter (inches) 4
  - (2) total depth (feet) 180
  - (3) static water level (feet) 40 below above top of ground.
  - (4) casing PVC, 60'  
(material) (depth)  
4" if telescope see back.  
(size)
  - (5) screen N/A  
(length) (depth to top)  
(size) (material)
  - (6) pump 1/2 8  
(HP) (yield gpm)  
(type power)
  - (7) electric log no  
(yes or no)  
no  
(organization running log)
  - (8) how well bottom plugged open

DEPT. OF NATURAL RESOURCES  
BUREAU OF LAND & WATER RESOURCES


JAN 7 1980

RECEIVED

DRILLERS REMARKS:

If well telescopes please sketch and show depths.

GROUND LEVEL

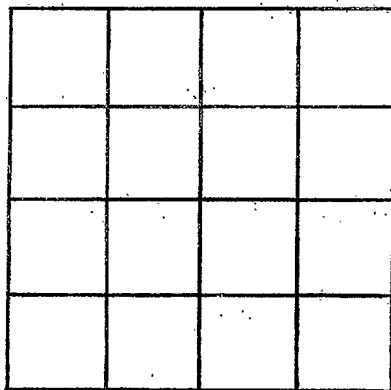

SECTION \_\_\_\_\_

Please indicate well location X.

ADDITIONAL INFORMATION

If more than one screen,  
show locations of each on sketch.