

LOWMEDES  
 7044  
 5-7-80  
 6-7-80

MISSISSIPPI  
 BOARD OF WATER COMMISSIONERS  
 416 North State Street  
 Jackson, Mississippi 39201

WATER WELL DRILLERS LOG

Martin S. R. [unclear]

Lowmedes

date well completed

firm name

county well located

LANDOWNER: Mrs Pearl [unclear]

description of formations encountered

from

to

Vernon Ala  
 (mailing address)

Brown clay 0 14

WELL LOCATION:

NW SW sec 23 T 18 N R 18 E  
 2 miles S.E. of [unclear] Miss

Gravel 14 22

Blue shale and sand 22 180

WELL PURPOSE:

(home, irrigation, municipal, industrial)

WELL COMPLETION DATA:

- (1) diameter (inches) 4" 80
- (2) total depth (feet) 180
- (3) static water level (feet) 13 below top of ground.
- (4) casing PVC; 78' (material) (depth)  
 4" if telescope see back. (size)
- (5) screen (length) (depth to top)  
 (size) 1/2 (material) 13
- (6) pump (HP) (yield gpm)  
 (type power)
- (7) electric log (yes or no)  
 (organization running log)
- (8) how well bottom plugged after


DRILLERS REMARKS:

DEPT OF NATURAL RESOURCES  
 BUREAU OF LAND & WATER RESOURCES

MAY 14 1980  
 RECEIVED

If well telescopes please sketch and show depths.

GROUND LEVEL

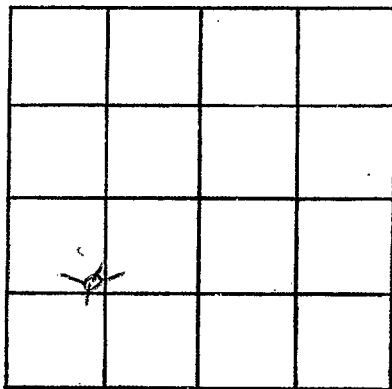

SECTION 23

Please indicate well location X.

ADDITIONAL INFORMATION

If more than one screen, show locations of each on sketch.