

MISSISSIPPI DEPARTMENT OF NATURAL RESOURCES

Bureau of Land and Water Resources

Southport Mall

P.O. Box 10631

Jackson, Mississippi 39209

WATER WELL DRILLERS LOG

LOWNDES
G 2045
8-14-80

8/14 1980 (Clardy Well Drilling Lowndes)  
 date well completed firm name county well located

LANDOWNER:	description of formations encountered	from	to
Ricky Williams	Sand & gravel	0	20
Columbus, Miss.	blue clay	20	90
(mailing address)	hard rock	90	
	blue clay	90	125
	hard rock	125	
	blue clay	125	160
	sand & rocks	160	180

WELL LOCATION:  
 sec. 11 T. 18 N. R. 18 E.  
 inside city limits  
 (distance) miles (direction) of (nearest town)

WELL PURPOSE: home  
 (home, irrigation, municipal, industrial)

WELL COMPLETION DATA:

(1) diameter (inches) 4"

(2) total depth (feet) 180'

(3) static water level (feet) 12 below above top of ground.

(4) casing PVC 60'  
 (material) (depth)

(size) if telescope see back.

(5) screen  
 (length) (depth to top)

(size) (material)

(6) pump 1/2 hp 250 gph  
 (hp) (yield gpm)

(type power)

(7) electric log No  
 (yes or no)

(organization running log)

(8) how well bottom plugged

DRILLERS REMARKS:


DEPT. OF NATURAL RESOURCES  
 BUREAU OF LAND & WATER RESOURCES

SEP 8 - 1980

RECEIVED

If well telescopes please sketch and show depths.

GROUND LEVEL

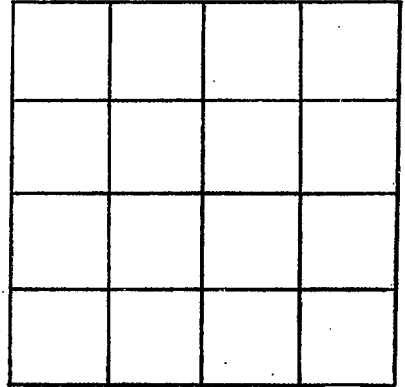

SECTION \_\_\_\_\_

Please indicate well location X.

ADDITIONAL INFORMATION

If more than one screen, show locations of each on sketch.