

MISSISSIPPI DEPARTMENT OF NATURAL RESOURCES

Bureau of Land and Water Resources

Southport Mall

P.O. Box 10631

Jackson, Mississippi 39209

WATER WELL DRILLERS LOG

LOWNDES  
G 2046  
8-23-80

8-23 1980 Clardy Well Drilling Lowndes  
 date well completed firm name county well located

LANDOWNER:	description of formations encountered	from	to
<u>Ed Williamson</u>			
<u>Columbus, Miss.</u> (mailing address)	<u>Sand &amp; gravel</u>	<u>7</u>	<u>30</u>
WELL LOCATION:	<u>blue clay</u>	<u>30</u>	<u>112</u>
sec. <u>34</u> T. <u>18</u> N. R. <u>15</u> E	<u>fine sand</u>	<u>112</u>	<u>132</u>
<u>2 1/2</u> miles <u>SO</u> of <u>Colo.</u>	<u>blue clay</u>	<u>132</u>	<u>165</u>
(distance) (direction) (nearest town)	<u>Sand &amp; rock</u>	<u>165</u>	<u>185</u>
WELL PURPOSE: <u>Trailer Court</u> (home, irrigation, municipal, industrial)	<u>blue clay</u>	<u>185</u>	<u>200</u>
WELL COMPLETION DATA:			
(1) diameter (inches) <u>4"</u>			
(2) total depth (feet) <u>200'</u>			
(3) static water level (feet) <u>30'</u> below top of ground.			
(4) casing <u>PVC, 110,</u> (material) (depth)			
<u>4"</u> <u>12'-2"</u> (size) if telescope see back.			
(5) screen <u>30'</u> (length) (depth to top)			
<u>2"</u> (size) (material)			
(6) pump <u>1/2</u> <u>800 gpm</u> (HP) (yield gpm)			
(type power)			
(7) electric log <u>IVC</u> (yes or no)			
(organization running log)			
(8) how well bottom plugged			
DRILLERS REMARKS:			


DEPT. OF NATURAL RESOURCES  
 BUREAU OF LAND & WATER RESOURCES

SEP 8 - 1980


RECEIVED

If well telescopes please sketch and show depths.

GROUND LEVEL

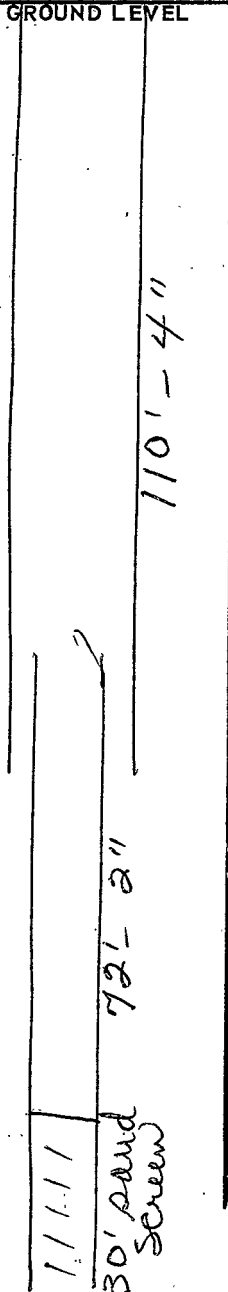

If more than one screen, show locations of each on sketch.

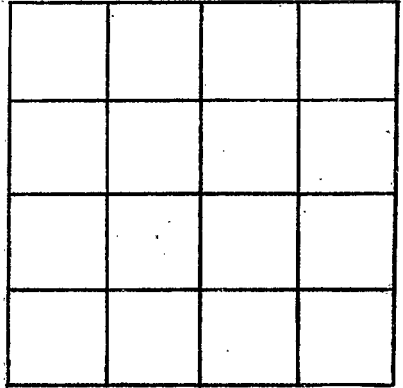

SECTION \_\_\_\_\_

Please indicate well location X.

ADDITIONAL INFORMATION

A series of horizontal lines for providing additional information.