

MISSISSIPPI DEPARTMENT OF NATURAL RESOURCES

Bureau of Land and Water Resources

Southport Mall

P.O. Box 10631

Jackson, Mississippi 39209

WATER WELL DRILLERS LOG

LOWNDES
G 2048
8-18-80

8/18/80 19 Clardy Well Drilling Lowndes
date well completed firm name county well located

LANDOWNER:
Kennedy Graham
Columbus, Miss.
(mailing address)

WELL LOCATION:
sec. 26-18 T. 18 N. R. 18 E.
1/2 miles So. of Colo.
(distance) (direction) (nearest town)

WELL PURPOSE: industrial
(home, irrigation, municipal, industrial)

WELL COMPLETION DATA:

- (1) diameter (inches) 4"
- (2) total depth (feet) 270'
- (3) static water level (feet) 6' below above top of ground.
- (4) casing PVC, 46'
(material) (depth)
 if telescope see back.
(size)
- (5) screen
(length) (depth to top)

(size) (material)
- (6) pump 1/2 800
(HP) (yield-gpm)
9 gph
(type power)
- (7) electric log no
(yes or no)

(organization running log)
- (8) how well bottom plugged

description of formations encountered	from	to
Sand & gravel	0	19
Blue Clay	19	55
Soft Clay & sand	55	65
rock	65	65
Blue Clay	65	118
fine sand	118	130
Blue Clay	130	150
rock	150	150
Blue Clay	150	160
rock	160	160
gummy blue clay	160	260
Sand	260	270

DRILLERS REMARKS:


DEPT. OF NATURAL RESOURCES
BUREAU OF LAND & WATER RESOURCES

SEP 8 - 1980

RECEIVED

If well telescopes please sketch and show depths.

GROUND LEVEL

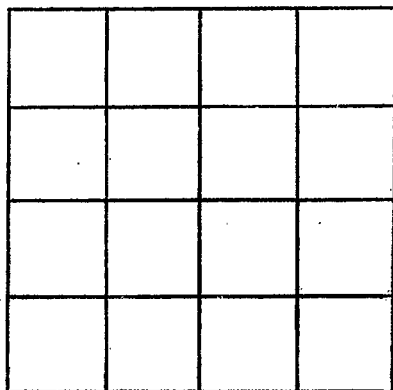

SECTION _____

Please indicate well location X.

ADDITIONAL INFORMATION

If more than one screen, show locations of each on sketch.