

MISSISSIPPI DEPARTMENT OF NATURAL RESOURCES

Bureau of Land and Water Resources

Southport Mall

P.O. Box 10631

Jackson, Mississippi 39209

WATER WELL DRILLERS LOG

Louder
G 7049
10-4-80

10-4 1980 Clardy Well Drilling Louder
 date well completed firm name county well located

LANDOWNER: Brad Martin
 Clardy Drive
 Columbus, Miss-
 (mailing address)

description of formations encountered	from	to
Sand & gravel	10	18
blue clay	18	80
streaks of sand	80	100
blue clay	100	145
sand	145	160

WELL LOCATION:
 sec. 13 T. 18 N. R. 18 E.
 in Columbus City limits
 (distance) miles (direction) of (nearest town)

WELL PURPOSE: home
 (home, irrigation, municipal, industrial)

- WELL COMPLETION DATA:
- (1) diameter (inches) 4"
 - (2) total depth (feet) 162'
 - (3) static water level (feet) 10' below top of ground.
 - (4) casing PVC 72' (material) (depth)
 4" (size) if telescope see back.
 - (5) screen (length) (depth to top)
 (size) (material)
 - (6) pump 1/2 800 gph (HP) (yield-gpm)
 (type power)
 - (7) electric log no. (yes or no)
 (organization running log)
 - (8) how well bottom plugged open

DRILLERS REMARKS:


DEPT. OF NATURAL RESOURCES
 BUREAU OF LAND & WATER RESOURCES

NOV - 6 1980

RECEIVED

If well telescopes please sketch and show depths.

GROUND LEVEL

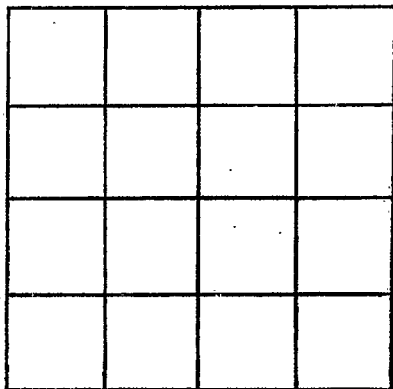

SECTION _____

Please indicate well location X.

ADDITIONAL INFORMATION

If more than one screen, show locations of each on sketch.