

LOWNDES

G 2057

8-31-78

MISSISSIPPI BOARD OF WATER COMMISSIONERS 416 North State Street Jackson, Mississippi 39201

WATER WELL DRILLERS LOG

Aug 31 1978 Mid South Drilling Co. Loundes date well completed firm name county well located

LANDOWNER: Dan Day Forest Glenn Road Columbus, MS 39701 (mailing address)

Table with 3 columns: description of formations encountered, from, to. Rows include clay, rock at 30', rock at 73', clay and sand, sand, clay + sand.

WELL LOCATION: sec 29 T 18 R 18 S 2 miles south of Col (distance) (direction) (nearest town)

WELL PURPOSE: home (home, irrigation, municipal, industrial)


- WELL COMPLETION DATA: (1) diameter (inches) 4" (2) total depth (feet) 330 (3) static water level (feet) 120 below top of ground (4) casing PVC 160 (material) (depth) (size) If telescope see back. (5) screen none (length) (depth to top) (size) (material) (6) pump 3/4 10 (HP) (yield gpm) no electric (type power) (7) electric log no (yes or no) none (organization running log) (8) how well bottom plugged open

RECEIVED NOV 27 1978 MISS. BD. OF WATER COMM

DRILLERS REMARKS:

If well telescopes please sketch and show depths.

GROUND LEVEL

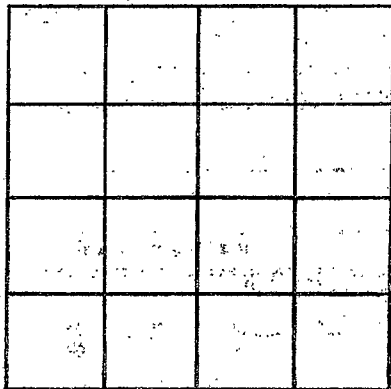

SECTION _____

Please indicate well location X.

ADDITIONAL INFORMATION

If more than one screen, show locations of each on sketch.