

Lowndes
G 2053
8-29-80

MISSISSIPPI
 BOARD OF WATER COMMISSIONERS
 416 North State Street
 Jackson, Mississippi 39201

WATER WELL DRILLERS LOG

8/29 1980 Abksup Drilling Inc. Lowndes
 date well completed firm name county well located


LANDOWNER: Dr. O Wendell Smith
Rt. 7, Box 20
Columbus Ms. 39701
 (mailing address)

description of formations encountered	from	to
top soil	0	15
FINE SAND	15	32 1/2

WELL LOCATION:
 sec. 3 T 18 N R 18 E
in city limits of Columbus
 (distance) miles (direction) (nearest town)

WELL PURPOSE: home
 (home, irrigation, municipal, industrial)

- WELL COMPLETION DATA:
- (1) diameter (inches) 4" x 2"
 - (2) total depth (feet) 324'
 - (3) static water level (feet) 188' below top of ground.
 - (4) casing 4" Plastic 160'
 (material) (depth)
 - 4" x 2" if telescope see back.
 (size)
 - (5) screen 2" 100' 224'
 (length) (depth to top)
 - 4" x 2" plastic
 (size) (material)
 - (6) pump 1 15
 (HP) (yield gpm)
 - Electric
 (type power)
 - (7) electric log NO
 (yes or no)
 - (organization running log)
 - (8) how well bottom plugged CAP

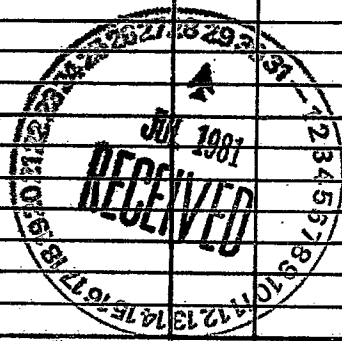

DRILLERS REMARKS:


If well telescopes please sketch and show depths.

GROUND LEVEL

160' 4"
Casing

70' 2"
Casing

100' 2"
Commercial
Screens

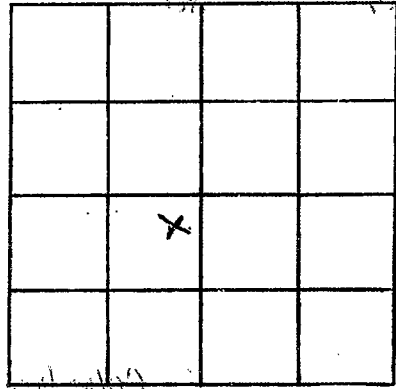

SECTION 3

Please indicate well location X.

ADDITIONAL INFORMATION

861

21

If more than one screen,
show locations of each on sketch.