

MISSISSIPPI DEPARTMENT OF NATURAL RESOURCES

Bureau of Land and Water Resources

Southport Mall

P.O. Box 10631

Jackson, Mississippi 39209

WATER WELL DRILLERS LOG

Lowndes

G 2056

1-23-81

1-23

1-23-81 date well completed *1981 Clardy Well Drilling* firm name *Lowndes* county well located

LANDOWNER: *A. J. Burns*
508 16th St
Columbus, Miss
 (mailing address)

description of formations encountered	from	to
Sand & gravel	10	35
blue clay	35	50
rock	50	
Clay	50	55
rock	55	
Clay	55	57
rock	57	
Clay	57	93
sand	93	94
Clay	94	124
sand	124	126
Clay	126	130
sand	130	131
Clay	131	136
sand	136	138

WELL LOCATION:
 sec. *35* T. *18* N. R. *18* E
 (S) (W)
2 miles *S* of *Colm*
 (distance) (direction) (nearest town)

WELL PURPOSE: *home*
 (home, irrigation, municipal, industrial)

WELL COMPLETION DATA:

(1) diameter (inches) *4"*

(2) total depth (feet) *138*

(3) static water level (feet) *18'* below above top of ground.

(4) casing *PVC*, *72*,
 (material) (depth)
 (size) if telescope see back.

(5) screen _____
 (length) (depth to top)
 (size) (material)

(6) pump *1/2* *800 gph*
 (HP) (yield gpm)
elec
 (type power)


(7) electric log (yes or no) _____
 (organization running log) _____

(8) how well bottom plugged *open*

DRILLERS REMARKS:

If well telescopes please
sketch and show depths.

GROUND LEVEL

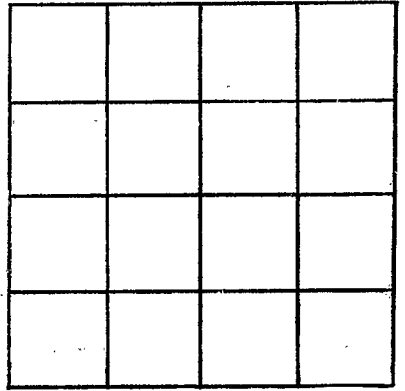

SECTION _____

Please indicate well location X.

ADDITIONAL INFORMATION

If more than one screen,
show locations of each on sketch.