

MISSISSIPPI DEPARTMENT OF NATURAL RESOURCES

Bureau of Land and Water Resources

Southport Mall

P.O. Box 10631

Jackson, Mississippi 39209

WATER WELL DRILLERS LOG

LOWIDES
G 2057
12-5-80

12-5 1980 Clardy Well Drilling Lowides
date well completed film name county well located

LANDOWNER: West
Ronnie West Const.
Columbus, Miss.
(mailing address)

WELL LOCATION:
sec 27 T 18 N R 18 E
3/4 miles So of Colv.
(distance) (direction) (nearest town)

WELL PURPOSE: Home
(home, irrigation, municipal, industrial)

- WELL COMPLETION DATA:
- (1) diameter (inches) 4"
 - (2) total depth (feet) 176'
 - (3) static water level (feet) 16' ^(below) _(above) top of ground.
 - (4) casing PVC, 72'
(material) (depth)
(size) if telescope see back.
 - (5) screen _____
(length) (depth to top)
(size) (material)
 - (6) pump 1/2 800 gph.
(HP) (yield gph.)
Elec.
(type power)
 - (7) electric log no
(yes or no)
(organization running log)
 - (8) how well bottom plugged _____

description of formations encountered	depth	
	from	to
Gravel	10	36
Clay	36	93
Sand	93	94
Clay	94	125
Sand	125	126
Clay	126	130
Sand	130	131
Clay	131	136
Sand	136	138
Clay	138	165
Sand	165	166
rock	166	168
Clay	168	169
rock	169	170
rock	170	171
Clay	171	174
rock	174	176

DEPT. OF NATURAL RESOURCES
BUREAU OF LAND & WATER RESOURCES


JAN 9 1981

RECEIVED

DRILLERS REMARKS:

If well telescopes please sketch and show depths.

GROUND LEVEL

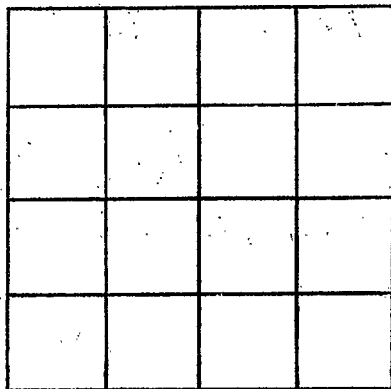

SECTION _____

Please indicate well location X.

ADDITIONAL INFORMATION

If more than one screen,
show locations of each on sketch.