

MISSISSIPPI DEPARTMENT OF NATURAL RESOURCES  
 Bureau of Land and Water Resources  
 Southport Mall  
 P.O. Box 10631

Jackson, Mississippi 39209  
**WATER WELL DRILLERS LOG**

<i>Lounded</i>
<i>G</i>
<i>7061</i>

*8-17* 19*82* *Clardy Well Drilling Lounded*  
 date well completed firm name county well located

LANDOWNER: *Columbus Backs*  
*Military Rd*  
*Columbus, Miss.*  
 (mailing address)

WELL LOCATION:  
 sec *10* T *18* N R *18* E  
*in Col. City limits*  
 (distance) (direction) (nearest town)

WELL PURPOSE: *ind.*  
 (home, irrigation, municipal, industrial)

WELL COMPLETION DATA:

- (1) diameter (inches) *4"*
- (2) total depth (feet) *281 1/2*
- (3) static water level (feet) \_\_\_\_\_ below above top of ground.
- (4) casing *PVC* *89'*  
 (material) (depth)  
 (size) if telescope see back.
- (5) screen \_\_\_\_\_  
 (length) (depth to top)  
 (size) (material)
- (6) pump *3/4* *1000*  
 (HP) (yield gpm) *gph*  
*elec.*  
 (type power)
- (7)  **PLUGGED** (yes or no)
- (8)  **FLOW WELL BOTTOM PLUGGED**


description of formations encountered	from	to
<i>red clay</i>	<i>5</i>	<i>11</i>
<i>sand &amp; gravel</i>	<i>11</i>	<i>32</i>
<i>blue clay</i>	<i>32</i>	<i>40</i>
<i>sandy clay</i>	<i>40</i>	<i>57</i>
<i>blue clay</i>	<i>57</i>	<i>61</i>
<i>rock 2"</i>	<i>61</i>	
<i>blue clay</i>	<i>61</i>	<i>66</i>
<i>rock 2"</i>	<i>66</i>	
<i>blue clay</i>	<i>66</i>	<i>67 1/2</i>
<i>rock 3"</i>	<i>67 1/2</i>	
<i>blue clay</i>	<i>67 1/2</i>	<i>76 1/2</i>
<i>rock 3"</i>	<i>74 1/2</i>	<i>75</i>
<i>sandy clay</i>	<i>75</i>	<i>76 1/2</i>
<i>rock 3"</i>	<i>76 1/2</i>	
<i>sandy clay</i>	<i>76 1/2</i>	<i>80</i>
<i>rock 2"</i>	<i>80</i>	
<i>blue clay</i>	<i>80</i>	<i>81</i>
<i>rock</i>	<i>81</i>	<i>81 1/2</i>
<i>sandy clay</i>	<i>81 1/2</i>	<i>85</i>
<i>blue clay</i>	<i>85</i>	<i>91</i>
<i>sand</i>	<i>91</i>	<i>93</i>
<i>clay</i>	<i>93</i>	<i>116</i>
<i>sandy clay</i>	<i>116</i>	<i>132</i>
<i>blue clay</i>	<i>122</i>	<i>139</i>
<i>sand</i>	<i>139</i>	<i>144</i>
<i>rock 2"</i>	<i>144</i>	
<i>blue clay</i>	<i>144</i>	<i>148</i>
<i>rock</i>	<i>148</i>	<i>148 1/2</i>
<i>blue clay</i>	<i>148 1/2</i>	<i>149</i>
<i>rock 3"</i>	<i>149</i>	
<i>blue clay</i>	<i>149</i>	<i>154</i>
<i>rock</i>	<i>154</i>	<i>154 1/2</i>
<i>sandy clay</i>	<i>154 1/2</i>	<i>158</i>
<i>blue clay</i>	<i>158</i>	<i>165</i>
<i>sand</i>	<i>165</i>	<i>169</i>
<i>blue clay</i>	<i>169</i>	<i>176</i>
<i>rock 2"</i>	<i>176</i>	
<i>sandy clay</i>	<i>176</i>	<i>179 1/2</i>
<i>rock</i>	<i>179 1/2</i>	<i>180</i>
<i>sandy clay</i>	<i>180</i>	<i>180 1/2</i>

DRILLERS REMARKS:

**RECEIVED**

If well telescopes please  
sketch and show depths.

GROUND LEVEL

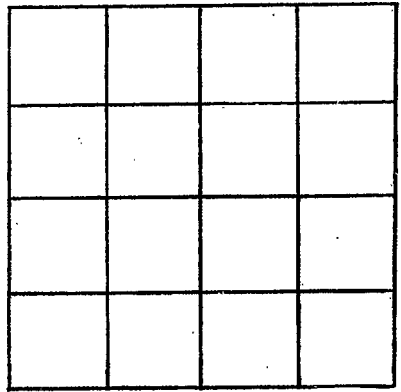

SECTION \_\_\_\_\_

Please indicate well location X.

ADDITIONAL INFORMATION

If more than one screen,  
show locations of each on sketch.