

MISSISSIPPI DEPARTMENT OF NATURAL RESOURCES

Bureau of Land and Water Resources

Southport Mall

P.O. Box 10631

Jackson, Mississippi 39209

WATER WELL DRILLERS LOG

LOWNDES
G 2062
3-9-81

3-9
 date well completed

19 81 P Dandy Well Drilling Lowndes
 firm name county well located

LANDOWNER: <u>Milton Starks</u>	description of formations encountered	from	to
<u>July 69</u>	Sand & gravel	15	80
<u>Columbus, Miss.</u> (mailing address)	Blue clay	30	83
WELL LOCATION:	sand	83	83 1/2
sec. <u>27</u> T- <u>18</u> N R- <u>18</u> E <div style="text-align: center;"> 5 </div> <u>1</u> miles <u>So.</u> of <u>Colo.</u> (distance) (direction) (nearest town)	Blue clay	83 1/2	85
WELL PURPOSE: <u>Home</u> (home, irrigation, municipal, industrial)	Sandy strata	85	89
WELL COMPLETION DATA:	Hard sand	89	91
(1) diameter (inches) <u>4"</u>	Blue clay	91	96
(2) total depth (feet) <u>160</u>	sand	96	96 1/2
(3) static water level (feet) <u>18'</u> below above top of ground.	Blue clay	96 1/2	98
(4) casing <u>PVC</u> <u>55'</u> (material) (depth)	sand	98	98 1/2
_____ if telescope see back. (size)	Blue clay	98 1/2	100
(5) screen _____ (length) (depth to top)	Sandy strata	100	110
_____ (size) _____ (material)	Hard sand	110	115
(6) pump <u>1/2</u> <u>800 gph</u> (HP) (yield gpm)	Sandy strata	115	125
_____ (type power)	Blue clay	125	144
(7) electric log _____ (yes or no)	sand	144	156
_____ (organization running log)	Clay	156	160
(8) how well bottom plugged _____			
DRILLERS REMARKS:			


DEPT. OF NATURAL RESOURCES
 BUREAU OF LAND & WATER RESOURCES

APR 10 1981

RECEIVED

If well telescopes please
sketch and show depths.

GROUND LEVEL

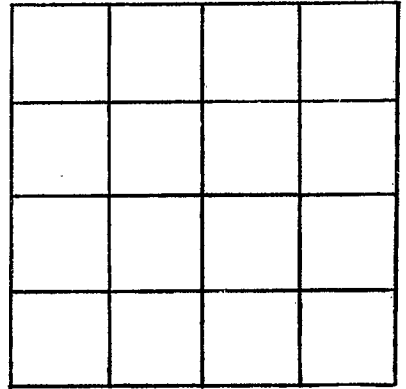

SECTION _____

Please indicate well location X.

ADDITIONAL INFORMATION

If more than one screen,
show locations of each on sketch.