

MISSISSIPPI DEPARTMENT OF NATURAL RESOURCES

Bureau of Land and Water Resources

Southport Mall

P.O. Box 10631

Jackson, Mississippi 39209

WATER WELL DRILLERS LOG

LOWNDES  
G 2063  
3-16-81

3-16 1981 Clardy Well Drilling Lowndes  
date well completed firm name county well located

LANDOWNER: L.W. Keshan  
16th Ave. So.  
Columbus, Miss.  
(mailing address)

WELL LOCATION:  
sec. 38 T 18 N R 18 E  
City of Colu  
(distance) miles (direction) of (nearest town)

WELL PURPOSE: Home  
(home, irrigation, municipal, industrial)

WELL COMPLETION DATA:

(1) diameter (inches) 4"  
(2) total depth (feet) 197  
(3) static water level (feet) 20 below above top of ground.  
(4) casing PVC 75 1/2 (material) (depth)  
(size) if telescope see back.  
(5) screen (length) (depth to top)  
(size) (material)  
(6) pump 3/4 1000 (HP) (yield gpm) gph.  
(type power)  
(7) electric log (yes or no)  
(organization running log)  
(8) how well bottom plugged


description of formations encountered	from	to
Gravel	9	51
Blue Clay	51	95
Rock cl	95	
Blue Clay	95	105
Sand	105	107
Clay	107	110
Sand	110	113
Clay	113	116
Sandy streaks	116	120
Clay	120	130
Sand	130	131
Clay	131	150
Sand	150	151
Clay	151	171
Good Sand	171	180
Sandy streaks	180	195
(Rock)	195	197

DRILLERS REMARKS:

DEPT. OF NATURAL RESOURCES  
BUREAU OF LAND & WATER RESOURCES  
APR 10 1981  
RECEIVED

If well telescopes please  
sketch and show depths.

GROUND LEVEL

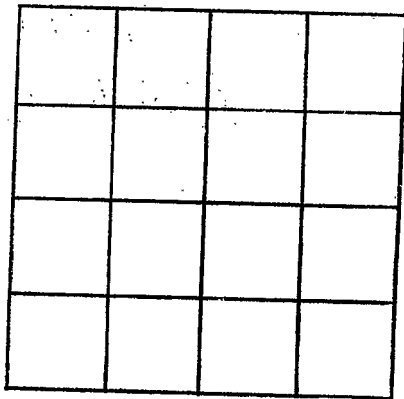

SECTION \_\_\_\_\_

Please indicate well location X.

ADDITIONAL INFORMATION

If more than one screen,  
show locations of each on sketch.