

MISSISSIPPI DEPARTMENT OF NATURAL RESOURCES

Bureau of Land and Water Resources

Southport Mall

P.O. Box 10631

Jackson, Mississippi 39209


WATER WELL DRILLERS LOG

Lowndes  
G 2064  
5/29/81  
15-29

date well completed


81 Clardy Well Drilling Lowndes  
firm name county well located

LANDOWNER:	description of formations encountered	from	to
Mike Smith Columbus, Ms. (mailing address)			
WELL LOCATION: sec. 26 T. 18 N. R. 18 E. 3/4 miles 50 of Colli. (distance) (direction) (nearest town)			
WELL PURPOSE: home (home, irrigation, municipal, industrial)			
WELL COMPLETION DATA:			
(1) diameter (inches) 4"			
(2) total depth (feet) 160			
(3) static water level (feet) 18 below top of ground.			
(4) casing PVC 75' (material) (depth)			
(size) If telescope see back.			
(5) screen (length) (depth to top)			
(size) (material)			
(6) pump 1/2 800 gph (HP) (yield gpm)			
(type power)			
(7) electric log (yes or no)			
(organization running log)			
(8) how well bottom plugged			
DRILLERS REMARKS:			

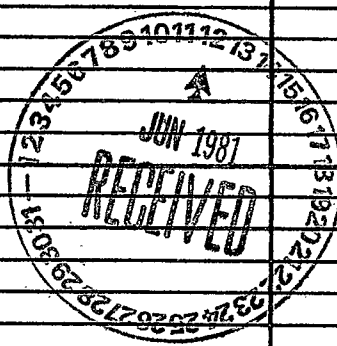

If well telescopes please sketch and show depths.

GROUND LEVEL

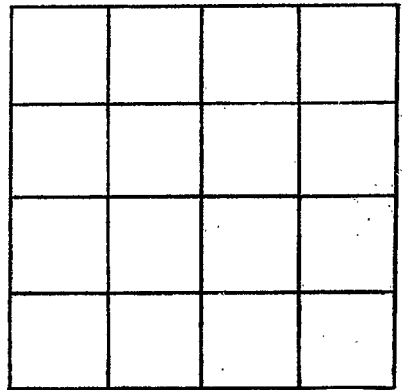

SECTION \_\_\_\_\_

Please indicate well location X.

ADDITIONAL INFORMATION

If more than one screen, show locations of each on sketch.