

MISSISSIPPI DEPARTMENT OF NATURAL RESOURCES

Bureau of Land and Water Resources

Southport Mall

P.O. Box 10631

Jackson, Mississippi 39209

WATER WELL DRILLERS LOG

LOWNDES
G 7066
8-11-81

8-11 date well completed. 80 Dandy Well Drilling firm name Lowndes county well located

LANDOWNER: Richard Holmes
1804 2nd Ave. No.
Columbus, Miss.
 (mailing address)

WELL LOCATION:
 sec. 34 T 18 N R. 18 E
3 miles So. of Colo
 (distance) (direction) (nearest town)

WELL PURPOSE: home
 (home, irrigation, municipal, industrial)

WELL COMPLETION DATA:

- (1) diameter (inches) 4"
- (2) total depth (feet) 152
- (3) static water level (feet) 10' below top of ground.
- (4) casing PVC 56'
 (material) (depth)
 (size) if telescope see back.
- (5) screen 0
 (length) (depth to top)
 (size) (material)
- (6) pump 1/2 1000 gpb.
 (HP) (yield gpm)
 (type power)
- (7) electric log (yes or no) _____
 (organization running log) _____
- (8) how well bottom plugged _____

description of formations encountered	depth	
	from	to
gravel	9	16
Clay	16	39
Sand	39	39 1/2
Clay	39 1/2	90
sandy streaks	90	105
rocks	105	109
sand	109	114
Sandy streaks	114	119
sand	119	127
Sandy clay	127	135
sand	135	137
good sand	137	152

DEPT. OF NATURAL RESOURCES
 BUREAU OF LAND & WATER RESOURCES


SEP 15 1981

RECEIVED

DRILLERS REMARKS: _____

If well telescopes please sketch and show depths.


GROUND LEVEL

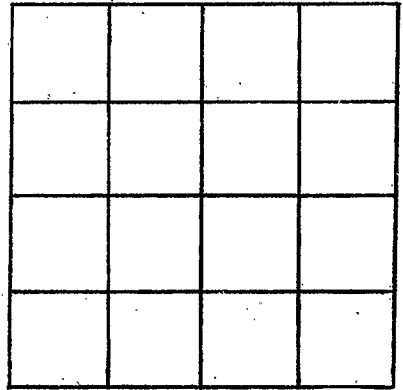

SECTION _____

Please indicate well location X.

ADDITIONAL INFORMATION

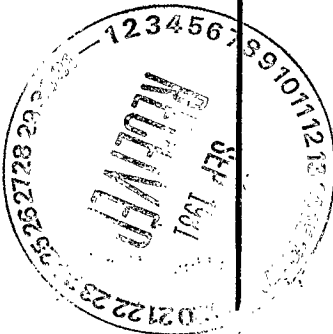

If more than one screen, show locations of each on sketch.