

MISSISSIPPI DEPARTMENT OF NATURAL RESOURCES

Bureau of Land and Water Resources

Southport Mall

P.O. Box 10631


Jackson, Mississippi 39209

WATER WELL DRILLERS LOG

Lowndes
G 2068
7-2-81

7-2 1981 Clardy Well Drilling Lowndes
 date well completed firm name county well located


LANDOWNER: <u>Wm J. E. Lawrence</u>	description of formations encountered	from	to
<u>Waverly Rd.</u> <u>Columbus, Miss.</u> (mailing address)			
WELL LOCATION: sec. <u>6</u> T <u>18</u> N R <u>18</u> E <u>1</u> miles <u>W</u> of <u>Columbus</u> (distance) (direction) (nearest town)	<u>Sand & gravel</u>	<u>17</u>	<u>35</u>
WELL PURPOSE: <u>home</u> (home, irrigation, municipal, industrial)	<u>Clay</u>	<u>35</u>	<u>37</u>
WELL COMPLETION DATA: (1) diameter (inches) <u>4"</u>	<u>rock</u>	<u>37</u>	
(2) total depth (feet) <u>163</u>	<u>Clay</u>	<u>37</u>	<u>45</u>
(3) static water level (feet) <u>30</u> below/above top of ground.	<u>rock</u>	<u>45</u>	
(4) casing <u>PVC</u> <u>55'4"</u> (material) (depth)	<u>Clay</u>	<u>45</u>	<u>66</u>
_____ if telescope see back. (size)	<u>rock</u>	<u>66</u>	
(5) screen _____ (length) (depth to top)	<u>Clay</u>	<u>66</u>	<u>143</u>
_____ (size) _____ (material)	<u>Sand (good)</u>	<u>143</u>	<u>150</u>
(6) pump <u>1/2 hp</u> <u>325 gpm</u> (HP) (yield gpm)	<u>breaks of sand</u>	<u>150</u>	<u>156</u>
_____ (type power)	<u>Sand (good)</u>	<u>156</u>	<u>161</u>
(7) electric log _____ (yes or no)	<u>Clay</u>	<u>161</u>	<u>163</u>
_____ (organization running log)			
(8) how well bottom plugged _____			

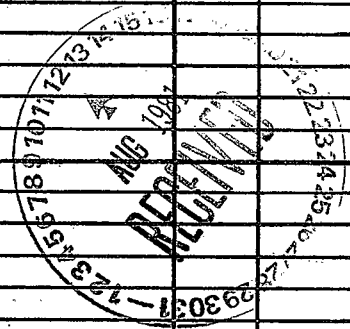

DRILLERS REMARKS:

If well telescopes please sketch and show depths.

GROUND LEVEL

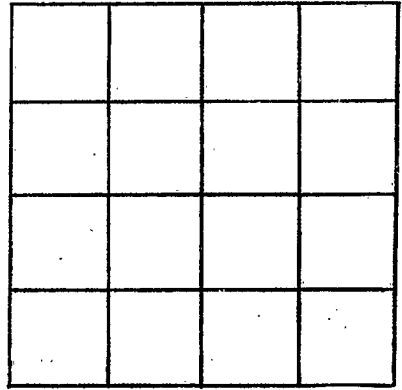

SECTION _____

Please indicate well location X.

ADDITIONAL INFORMATION

If more than one screen,
show locations of each on sketch.