

MISSISSIPPI DEPARTMENT OF NATURAL RESOURCES

Bureau of Land and Water Resources

Southport Mall

P.O. Box 10631

Jackson, Mississippi 39209

WATER WELL DRILLERS LOG

LOWNDES
 2069
 11-13-81

11-13 19 Clardy Well Drilling Lowndes
 date well completed firm name county well located

LANDOWNER: Frank Jones
Holly Hill apt 143
Columbus, Ms.
 (mailing address)

WELL LOCATION:
 sec. 18 T. 18 N. R. 18 E.
3/4 miles W of Col.
 (distance) (direction) (nearest town)

WELL PURPOSE: Home
 (home, irrigation, municipal, industrial)

WELL COMPLETION DATA:

- (1) diameter (inches) 4"
- (2) total depth (feet) 165'
- (3) static water level (feet) 27' below above top of ground.
- (4) casing PVC 75'
 (material) (depth)
 (size) if telescope see back.
- (5) screen _____
 (length) (depth to top)
 (size) (material)
- (6) pump 1/2 900gph
 (HP) (yield gpm)
elec.
 (type power)
- (7) electric log No
 (yes or no)
 (organization running log)
- (8) how well bottom plugged 0

description of formations encountered	from	to
Gravel	18	26
Clay	26	82
Brown Sandy Clay	82	90
rock	90	
blu. Clay	90	96
Strunks of Sand	96	108
Clay	108	113
sand	113	114
Clay	114	115
rock	115	116
Clay	116	117
rock, 3"	117	
Clay	117	120
sand	120	123
rock	123	
Strunks of Sand	123	136
Clay	136	139
sand	139	142
Clay	142	144
sand	144	149
Clay	149	155
sand Strunks	155	164
Clay	164	165

DEPT. OF NATURAL RESOURCES
 BUREAU OF LAND & WATER RESOURCES


DEC 18 1981

RECEIVED

DRILLERS REMARKS:

If well telescopes please sketch and show depths.

GROUND LEVEL

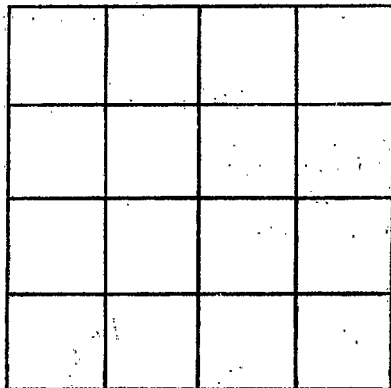

SECTION _____

Please indicate well location X.

ADDITIONAL INFORMATION

If more than one screen, show locations of each on sketch.