

MISSISSIPPI DEPARTMENT OF NATURAL RESOURCES

Bureau of Land and Water Resources

Southport Mall

P.O. Box 10631

Jackson, Mississippi 39209

WATER WELL DRILLERS LOG

Lowndes
G 2070

12-21-81
date well completed

Clardy Well Drilling
firm name

Lowndes
county well located

LANDOWNER: Bob's Place
 Hwy 82 West
 Columbus, Miss.
(mailing address)

WELL LOCATION:
sec. 28 T. 18 N. R. 18 E.
at city limits
miles (distance) (direction) of (nearest town)

WELL PURPOSE: Restaurant
(home, irrigation, municipal, industrial)

WELL COMPLETION DATA:

- (1) diameter (inches) 4"
- (2) total depth (feet) 181 1/2
- (3) static water level (feet) 28 below above top of ground.
- (4) casing PVC 87'
(material) (depth)
if telescope see back.
(size)
- (5) screen _____
(length) (depth to top)
(size) (material)
- (6) pump 1/2 900 gph
(HP) (yield-gpm)
elec.
(type power)
- (7) electric log no
(yes or no)
(organization running log)
- (8) how well bottom plugged _____

description of formations encountered	from	to
<u>sand & gravel</u>	<u>0</u>	<u>51</u>
<u>clay</u>	<u>51</u>	<u>118 1/2</u>
<u>sand</u>	<u>118 1/2</u>	<u>127</u>
<u>clay</u>	<u>127</u>	<u>167</u>
<u>sand</u>	<u>167</u>	<u>171</u>
<u>clay</u>	<u>171</u>	<u>172 1/2</u>
<u>sand</u>	<u>172 1/2</u>	<u>173 1/2</u>
<u>clay</u>	<u>173 1/2</u>	<u>175</u>
<u>good sand</u>	<u>175</u>	<u>181 1/2</u>

DRILLERS REMARKS:


DEPT. OF NATURAL RESOURCES
BUREAU OF LAND & WATER RESOURCES

JAN 28 1982

RECEIVED

If well telescopes please sketch and show depths.

GROUND LEVEL

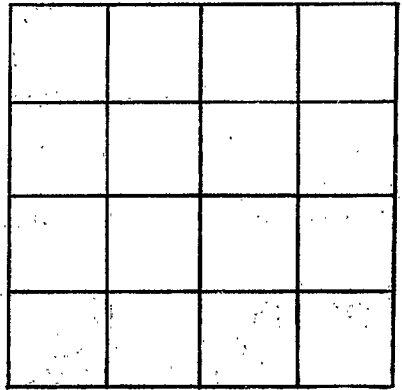

SECTION _____

Please indicate well location X.

ADDITIONAL INFORMATION

If more than one screen,
show locations of each on sketch.