

MISSISSIPPI DEPARTMENT OF NATURAL RESOURCES

Bureau of Land and Water Resources

Southport Mall

P.O. Box 10631

Jackson, Mississippi 39209

WATER WELL DRILLERS LOG

Louder
G
2074

7-6 date well completed Blardy Well Drilling Louder firm name county well located

LANDOWNER: Johnny Stewart
Columbus, Miss.
397.01
(mailing address)

WELL LOCATION:
sec 26 T 18 N R 18 E
1/2 miles So. of Colo.
(distance) (direction) (nearest town)

WELL PURPOSE: home
(home, irrigation, municipal, industrial)

- WELL COMPLETION DATA:
- (1) diameter (inches) 4"
 - (2) total depth (feet) 130
 - (3) static water level (feet) 40 below above top of ground.
 - (4) casing PVC, 55'
(material) (depth)
 if telescope see back.
(size)
 - (5) screen (length) (depth to top)
 (size) (material)
 - (6) pump 1/2 gph
(HP) (field gpm)
elec.
(type power)
 - (7) electric log no
(yes or no)
 (organization running log)
 - (8) how well bottom plugged

description of formations encountered	from	to
sand & gravel	10	34
clay	34	59
sandy clay	59	66
blue clay	66	107
fine sand	107	109
rock (in)	109	
clay	109	110 1/2
fine sand	110 1/2	123
rock (in)	123	
clay	123	128
sand	128	128 1/2
clay	128 1/2	130

DRILLERS REMARKS:


DEPT. OF NATURAL RESOURCES
BUREAU OF LAND & WATER RESOURCES

AUG 20 1982

RECEIVED

If well telescopes please sketch and show depths.

GROUND LEVEL

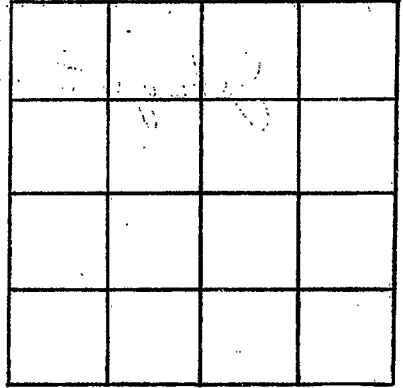

SECTION _____

Please indicate well location X.

ADDITIONAL INFORMATION

If more than one screen,
show locations of each on sketch.