

MISSISSIPPI DEPARTMENT OF NATURAL RESOURCES  
 Bureau of Land and Water Resources  
 Southport Mall  
 P.O. Box 10631  
 Jackson, Mississippi 39209  
**WATER WELL DRILLERS LOG**

Lowndes  
G 2080

June 30 1983 Allsup Drilling, Inc. Lowndes  
 date well completed firm name county well located

LANDOWNER: John Land	description of formations encountered	from	to
RR 5, Box 376			
Columbus, MS 39701 (mailing address)	GRAVEL	10'	40'
WELL LOCATION:	BLUE CLAY	40'	120'
sec. 8 T-18 N R-18 W	BLUE FINE SAND	120'	170'
1/2 miles West of Columbus (distance) (direction) (nearest town)	MUCK	170'	200'
WELL PURPOSE: Home (home, irrigation, municipal, industrial)	SAND	200'	240'
WELL COMPLETION DATA:	MUCK	240'	260'
(1) diameter (inches) 4"	WATER SAND	260'	316'
(2) total depth (feet) 316'			
(3) static water level (feet) 15' below top of ground.			
(4) casing PVC, 120' (material) (depth)			
4" if telescope see back. (size)			
(5) screen None, customer did not want it. (length) (depth to top)			
(size) (material)			
(6) pump 1 35 (HP) (yield gpm)			
Electric (type power)			
(7) electric log no (yes or no)			
(organization running log)			
(8) how well bottom plugged capped			

DEPT. OF NATURAL RESOURCES  
 BUREAU OF LAND & WATER RESOURCES

JAN 27 1984

**RECEIVED**


DRILLERS REMARKS:

If well telescopes please sketch and show depths.

GROUND LEVEL

120' 4" CASING

316' DRILLING

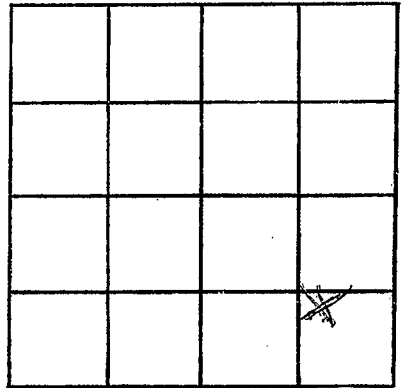

SECTION 8

Please indicate well location X.

ADDITIONAL INFORMATION

If more than one screen,  
show locations of each on sketch.