

Lowndes
G
2081

MISSISSIPPI
BOARD OF WATER COMMISSIONERS
416 North State Street
Jackson, Mississippi 39201

9/12/83

WATER WELL DRILLERS LOG

July 20 1983 Mid South Drilling Company Lowndes
date well completed firm name county well located

LANDOWNER: Richard Thompson
Rt. 7 Box 2448
Columbus, MS 39701
(mailing address)

description of formations encountered	from to	
clay	0	11
sand and gravel	11	25
clay	25	135
clay and sand	135	195

WELL LOCATION:
sec. 17 T. 19 N R. 18 E
City limits of Col, W
(distance) miles (direction) of (nearest town)

WELL PURPOSE: home
(home, irrigation, municipal, industrial)

- WELL COMPLETION DATA:
- (1) diameter (inches) 4
 - (2) total depth (feet) 195
 - (3) static water level (feet) 40 below top of ground.
 - (4) casing PVC 130 (material) (depth)
 - (size) if telescope see back.
 - (5) screen 10 185 (length) (depth to top)
 - (size) (material)
 - (6) pump (HP) (yield gpm)
 - (type power)
 - (7) electric log (yes or no)
 - (organization running log)
 - (8) how well bottom plugged OPEN

DEPT. OF NATURAL RESOURCES
BUREAU OF LAND & WATER RESOURCES


SEP 12 1983

RECEIVED

DRILLERS REMARKS:

If well telescopes please sketch and show depths.

GROUND LEVEL

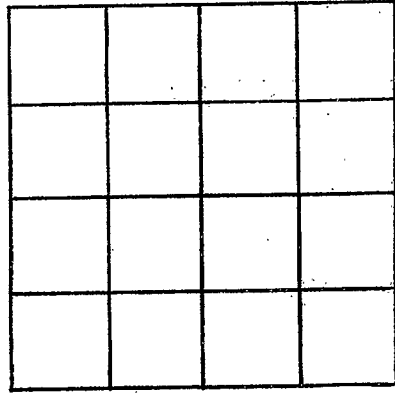

SECTION _____

Please indicate well location X.

ADDITIONAL INFORMATION

A series of horizontal lines for entering additional information, starting below the 'ADDITIONAL INFORMATION' header and ending above the bottom border.

If more than one screen, show locations of each on sketch.