

MISSISSIPPI DEPARTMENT OF NATURAL RESOURCES

Bureau of Land and Water Resources

Southport Mall

P.O. Box 10631

Jackson, Mississippi 39209

WATER WELL DRILLERS LOG

Lowndes
G
2083

12/13/83 date well completed Clardy Wood Drilling Lowndes firm name Lowndes county well located

LANDOWNER: Clyde Stokes
Highway 50
Columbus, Ms.
 (mailing address)

WELL LOCATION:
 sec. 12 T. 18 N. R. 18 E. W
City of Col.
 (distance) miles (direction) of (nearest town)

WELL PURPOSE: home
 (home, irrigation, municipal, industrial)

WELL COMPLETION DATA:

- (1) diameter (inches) 4"
- (2) total depth (feet) 182'
- (3) static water level (feet) 18' below above top of ground.
- (4) casing PVC 100'
 (material) (depth)
 (size) if telescope see back.
- (5) screen _____
 (length) (depth to top)
 (size) (material)
- (6) pump 1/2 900' gph
 (HP) (yield gpm)
elec.
 (type power)
- (7) electric log no
 (yes or no)
 (organization running log)
- (8) how well bottom plugged C


description of formations encountered	from	to
red clay	0	18
sand & gravel	18	39
sandy blue clay	39	68
good clay	68	70
sandy clay	70	95
good clay	95	101
rock	101	101 1/2
sandy clay	101 1/2	105
good clay	105	107 1/2
rock	107 1/2	108
sandy clay	108	111
sand	111	115
good clay	115	141
wood	141	143
good clay	143	159
sand	159	161
clay	161	168
sand	168	182

MISSISSIPPI DEPARTMENT OF NATURAL RESOURCES
 BUREAU OF LAND & WATER RESOURCES
 JAN 28 1984
RECEIVED

DRILLERS REMARKS:

If well telescopes please
sketch and show depths.

GROUND LEVEL

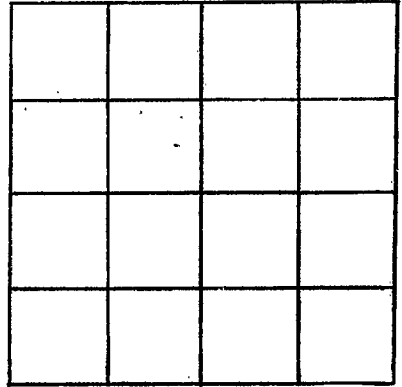

SECTION _____

Please indicate well location X.

ADDITIONAL INFORMATION

If more than one screen,
show locations of each on sketch.