

MISSISSIPPI DEPARTMENT OF NATURAL RESOURCES

Bureau of Land and Water Resources

Southport Mall

P.O. Box 10631

Jackson, Mississippi 39209

WATER WELL DRILLERS LOG

Journal
G
2085

3-12
date well completed

846 Clardy Well Drilling
firm name

Louisa
county well located

LANDOWNER: Johnny Boone
Henry
Columbus, MS.
(mailing address)

WELL LOCATION:
sec. 12 T. 12 N. R. 12 E.
City of miles 7 of Colo. (nearest town)
(distance) (direction)

WELL PURPOSE: home
(home, irrigation, municipal, industrial)

WELL COMPLETION DATA:

- (1) diameter (inches) 4"
- (2) total depth (feet) 174'
- (3) static water level (feet) 12' below top of ground.
- (4) casing PVC 86'
(material) (depth)
 if telescope see back.
(size)
- (5) screen 30'
(length) (depth to top)
3" PVC
(size) (material)
- (6) pump 1/2 900 gpm
(HP) (yield gpm)
elec.
(type power)
- (7) electric log no
(yes or no)

(organization running log)
- (8) how well bottom plugged

description of formations encountered	from	to
Clay	0	14
sand & gravel	14	35
blue clay	35	48
sandy-rock	48	67
rock	67	
soft blue clay	67	79
rock	79	
rocky	79	83
good clay	83	88
rock	88	89
blue clay & rocks	89	122
sand	122	129
blue clay	129	139
rock	139	
brown clay	139	145
black clay	145	150
brown-red clay	150	161
sand	161	174

DEPT. OF NATURAL RESOURCES
BUREAU OF LAND & WATER RESOURCES



APR 30 1981

RECEIVED

DRILLERS REMARKS:

If well telescopes please sketch and show depths.

GROUND LEVEL

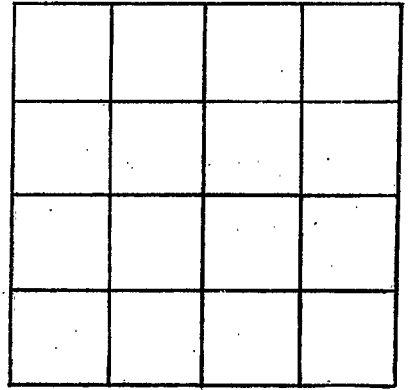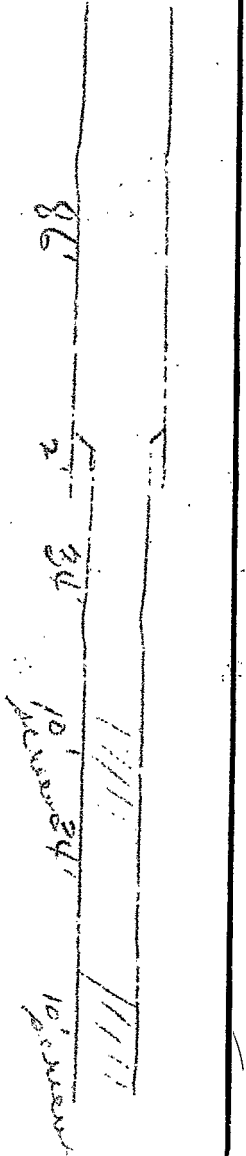

SECTION _____

Please indicate well location X.

ADDITIONAL INFORMATION

If more than one screen,
show locations of each on sketch.