

Lowdes  
G  
2086

MISSISSIPPI  
BOARD OF WATER COMMISSIONERS  
416 North State Street  
Jackson, Mississippi 39201

WATER WELL DRILLERS LOG

3-19-84 19 Mid South Drilling Company Lowdes  
date well completed firm name county well located

LANDOWNER: Sobley Excavating  
P. O. Box 2040  
Columbus, MS 39701  
(mailing address)

WELL LOCATION:  
sec. 23 T 18 N S R 18 E W  
miles in Columbus  
(distance) (direction) (nearest town)

WELL PURPOSE: wash equipment  
(home, irrigation, municipal, industrial)

WELL COMPLETION DATA:  
(1) diameter (inches) 4  
(2) total depth (feet) 180  
(3) static water level (feet) 30 below  
top of ground. ~~above~~  
(4) casing PVC 105  
(material) (depth)  
4" if telescope see back.  
(size)  
(5) screen none  
(length) (depth to top)  
(size) (material)  
(6) pump 3/4 15  
(HP) (yield gpm)  
electric  
(type power)  
(7) electric log no  
(yes or no)  
no  
(organization running log)  
(8) how well bottom plugged open

description of formations encountered	from	to
sand	0	15
sand and gravel	15	42
clay	42	60
clay and sand	60	180


DEPT. OF NATURAL RESOURCES  
BUREAU OF LAND & WATER RESOURCES

MAY 21 1984  
RECEIVED

DRILLERS REMARKS:

If well telescopes please sketch and show depths.

GROUND LEVEL

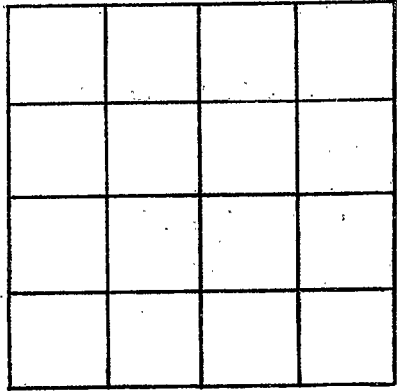

SECTION \_\_\_\_\_

Please indicate well location X.

ADDITIONAL INFORMATION

If more than one screen,  
show locations of each on sketch.