

MISSISSIPPI DEPARTMENT OF NATURAL RESOURCES

Bureau of Land and Water Resources

Southport Mall

P.O. Box 10631

Jackson, Mississippi 39209

WATER WELL DRILLERS LOG

Lowndes
6
2087

4-21-84 date well completed Clardy Well Drilling Lowndes firm name Lowndes county well located

LANDOWNER: Ella Golden
Rt 3 Box 29
Columbus, Ms.
 (mailing address)

WELL LOCATION:
 sec. 29 T. 18 N. R. 18 E.
1/2 miles W of Colo.
 (distance) (direction) (nearest town)

WELL PURPOSE: home
 (home, irrigation, municipal, industrial)

WELL COMPLETION DATA:

- (1) diameter (inches) 4"
- (2) total depth (feet) 230'
- (3) static water level (feet) 18' below above top of ground.
- (4) casing PVC 70
 (material) (depth)
 (size) if telescope see back.
- (5) screen _____
 (length) (depth to top)
 (size) (material)
- (6) pump 1/2 900gph
 (HP) (yield gpm)
elec.
 (type power)
- (7) electric log No.
 (yes or no)
 (organization running log)
- (8) how well bottom plugged _____

description of formations encountered	from	to
sand	0	15
sandy clay	15	18
brack.	18	27
sandy clay	27	52
good clay	52	54
sandy clay	54	64
good clay	64	67
sandy clay	67	124
rock	124	124 1/2
sandy clay	124 1/2	131
hard clay	131	194
good sand	194	203
sandy clay	203	221 1/2
rock	221 1/2	222
sand	222	228
blue clay	228	230

DEPT. OF NATURAL RESOURCES
 BUREAU OF LAND & WATER RESOURCES


MAY 29 1984

RECEIVED

DRILLERS REMARKS:

If well telescopes please sketch and show depths.

GROUND LEVEL

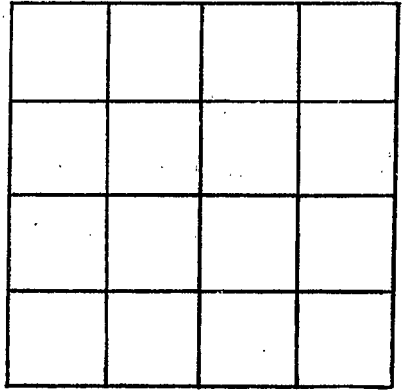

SECTION _____

Please indicate well location X.

ADDITIONAL INFORMATION

If more than one screen,
show locations of each on sketch.