

MISSISSIPPI DEPARTMENT OF NATURAL RESOURCES  
Bureau of Land and Water Resources  
Southport Mall  
P.O. Box 10631  
Jackson, Mississippi 39209.  
**WATER WELL DRILLERS LOG**

Louder  
G  
2088

4-24-84 19 Clardy Well Drilling Louder  
date well completed firm name county well located

LANDOWNER: Betty Lewis  
Rt 3 Box 29  
Columbus, Miss  
(mailing address)

WELL LOCATION:  
sec. 29 T. 18 N. R. 18 E.  
1/2 miles W. of Colo.  
(distance) (direction) (nearest town)

WELL PURPOSE: home  
(home, irrigation, municipal, industrial)

WELL COMPLETION DATA:

(1) diameter (inches) 4"

(2) total depth (feet) 230'

(3) static water level (feet) 18' below above top of ground.

(4) casing Pvc, 72'  
(material) (depth)

if telescope see back.  
(size)

(5) screen ,   
(length) (depth to top)

,   
(size) (material)

(6) pump 1/2 900 gpl.  
(HP) (yield gpm)

elec.  
(type power)

(7) electric log no.  
(yes or no)

(organization running log)

(8) how well bottom plugged

description of formations encountered	from	to
sand	0	17
gravel	17	28
sandy clay rock	28	28 1/2
rock	28 1/2	29
sandy clay	29	55
good clay	55	55 1/2
rock	55 1/2	56
sandy clay	56	66
good clay	66	68 1/2
sandy clay	68 1/2	124 1/2
rock	124 1/2	125
sandy clay	125	128
rock	128	128 1/2
sandy clay	128 1/2	140
hard clay	140	195
good sand	195	224
rock 2"	224	
sand	224	228
blue clay	228	230

DEPT. OF NATURAL RESOURCES  
BUREAU OF LAND & WATER RESOURCES  
BUREAU OF LAND & WATER RESOURCES


**MAY 29 1984**

**RECEIVED**

DRILLERS REMARKS:

If well telescopes please  
sketch and show depths.

GROUND LEVEL

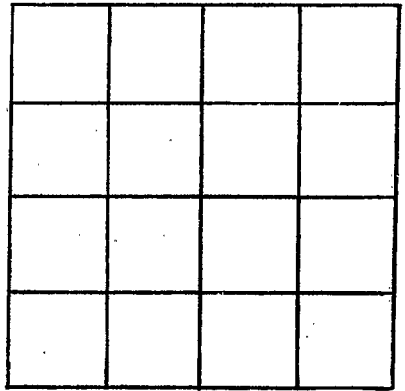

SECTION \_\_\_\_\_

Please indicate well location X.

ADDITIONAL INFORMATION

If more than one screen,  
show locations of each on sketch.