

MISSISSIPPI DEPARTMENT OF NATURAL RESOURCES

Bureau of Land and Water Resources

Southport Mall

P.O. Box 10631

Jackson, Mississippi 39209

WATER WELL DRILLERS LOG

Lowndes  
G  
2089

5-3-84 19 cloudy well drilling Lowndes  
date well completed firm name county well located

LANDOWNER: Robert Blunt  
Hwy 69  
Columbus, Ms.  
(mailing address)

WELL LOCATION:  
sec. 36 T-18N R-18E  
1 miles 50 of Colo.  
(distance) (direction) (nearest town)

WELL PURPOSE: home  
(home, irrigation, municipal, industrial)

WELL COMPLETION DATA:

- (1) diameter (inches) 4"
- (2) total depth (feet) 167'
- (3) static water level (feet) 32' below above top of ground.
- (4) casing PVC 74"  
(material) (depth)  
         if telescope see back.  
(size)
- (5) screen           
(length) (depth to top)  
         (size) (material)
- (6) pump 1/2 900 gpd  
(HP) (yield ~~gpm~~)  
elec  
(type power)
- (7) electric log no  
(yes or no)  
          
(organization running log)
- (8) how well bottom plugged


description of formations encountered	from	to
<u>brown clay</u>	<u>0</u>	<u>10</u>
<u>sand &amp; gravel</u>	<u>10</u>	<u>39</u>
<u>thin clay</u>	<u>39</u>	<u>61</u>
<u>sandy clay</u>	<u>61</u>	<u>69</u>
<u>good clay</u>	<u>69</u>	<u>91</u>
<u>sand</u>	<u>91</u>	<u>93</u>
<u>clay</u>	<u>93</u>	<u>119</u>
<u>sandy clay</u>	<u>119</u>	<u>124</u>
<u>sand</u>	<u>124</u>	<u>126</u>
<u>rock 2"</u>	<u>126</u>	<u>        </u>
<u>sandy clay</u>	<u>126</u>	<u>132</u>
<u>sand</u>	<u>132</u>	<u>135</u>
<u>sandy clay</u>	<u>135</u>	<u>140</u>
<u>sand</u>	<u>140</u>	<u>143</u>
<u>clay</u>	<u>143</u>	<u>167</u>

DRILLERS REMARKS:         

DEPT. OF NATURAL RESOURCES  
BUREAU OF LAND & WATER RESOURCES  
RECEIVED  
JUL - 9 1984

If well telescopes please sketch and show depths.

GROUND LEVEL

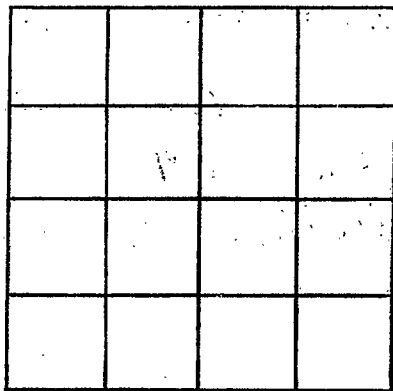

SECTION \_\_\_\_\_

Please indicate well location X.

ADDITIONAL INFORMATION

If more than one screen,  
show locations of each on sketch.