

Lowndes
G
2090

MISSISSIPPI
 BOARD OF WATER COMMISSIONERS
 416 North State Street
 Jackson, Mississippi 39201
 WATER WELL DRILLERS LOG

May 4 1984 Mid South Drilling Company Lowndes
 date well completed firm name county well located


LANDOWNER: R. W. Bolton	description of formations encountered	from	to
807 Tuscaloosa Road			
Columbus, MS 39701 (mailing address)	sand and gravel	6	21
WELL LOCATION: sec. 1 T. 18 N. R. 18 E S W	clay	21	75
3 miles east of Columbus (distance) (direction) (nearest town)	clay and sand	75	90
WELL PURPOSE: home (home, irrigation, municipal, industrial)	clay	90	105
WELL COMPLETION DATA:	clay and sand	105	195
(1) diameter (inches) 4"			
(2) total depth (feet) 195			
(3) static water level (feet) 20 XXX below top of ground.			
(4) casing PVC 120' (material) (depth) 4" if telescope see back. (size)			
(5) screen none (length) (depth to top) (size) (material)			
(6) pump none (HP) (yield gpm) (type power)			
(7) electric log no (yes or no) none (organization running log)			
(8) how well bottom plugged open			

DRILLERS REMARKS:

DEPT. OF NATURAL RESOURCES
 BUREAU OF MINES & WATER RESOURCES
 MAY 21 1984
 RECEIVED

If well telescopes please sketch and show depths.

GROUND LEVEL

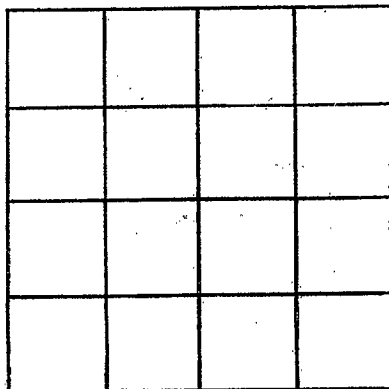

SECTION _____

Please indicate well location X.

ADDITIONAL INFORMATION

A series of horizontal lines providing space for additional information.

If more than one screen, show locations of each on sketch.