

MISSISSIPPI DEPARTMENT OF NATURAL RESOURCES

Bureau of Land and Water Resources

Southport Mall

P.O. Box 10631

Jackson, Mississippi 39209

WATER WELL DRILLERS LOG

Lowder  
G  
2091

5-8-84 date well completed      Clardy Wee. Drilling Lowder firm name      J county well located

LANDOWNER: Samuel Stokes  
Rt 8 Box 104-A  
Columbus, Ms.  
(mailing address)

WELL LOCATION:  
sec. 36 T. 18 N. R. 18 E  
1 miles So of Col.  
(distance) (direction) (nearest town)

WELL PURPOSE: home  
(home, irrigation, municipal, industrial)

WELL COMPLETION DATA:

(1) diameter (inches) 4"

(2) total depth (feet) 198 1/2

(3) static water level (feet) 20' below above top of ground.

(4) casing Pvc 93  
(material) (depth)  
(size) if telescope see back.

(5) screen \_\_\_\_\_ (length) \_\_\_\_\_ (depth to top)  
(size) (material)

(6) pump 1/2 900 gph  
(HP) (yield gph)  
elec.  
(type power)

(7) electric log no  
(yes or no)  
(organization running log)

(8) how well bottom plugged \_\_\_\_\_


description of formations encountered	from	to
Brown clay	0	10
sand & gravel	10	32
Blue clay	32	49
sandy clay	49	68
good clay	68	86
throw clay	86	89
good blue clay	89	93
sand	93	94
blue clay	94	106
sandy clay	106	115
sand	115	118
sandy clay	118	131
hard clay	131	145
sandy clay	145	156
rock	156	159
sand	159	169
rock	169	169 1/2
sandy clay	169 1/2	174
sand	174	177
sandy clay	177	187
rock	187	187 1/2
sand	187 1/2	194
rock	194	194 1/2
Clay	194 1/2	198 1/2
rock	198 1/2	

DRILLERS REMARKS:

RECEIVED  
JUL 2 1984  
DEPT. OF NATURAL RESOURCES  
BUREAU OF LAND & WATER RESOURCES

If well telescopes please  
sketch and show depths.

GROUND LEVEL

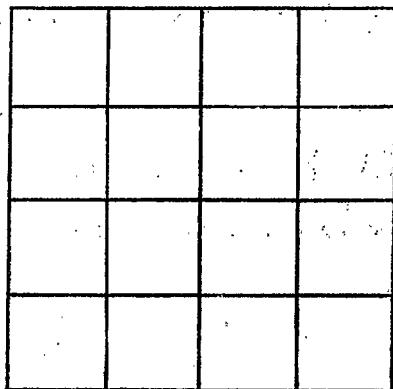

SECTION \_\_\_\_\_

Please indicate well location X.

ADDITIONAL INFORMATION

If more than one screen,  
show locations of each on sketch.