

Lowndes
G
2092

MISSISSIPPI DEPARTMENT OF NATURAL RESOURCES
 Bureau of Land and Water Resources
 Southport Mall
 P.O. Box 10631
 Jackson, Mississippi 39209
WATER WELL DRILLERS LOG

May 11 19 84 Allsup Drilling, Inc. Lowndes
 date well completed firm name county well located

LANDOWNER:	description of formations encountered	from	to
<u>Hooker Chemical Corporation</u>	<u>Clay Top Soil</u>	<u>0'</u>	<u>8'</u>
<u>Nashville Ferry Rd.</u>	<u>Gravel</u>	<u>8'</u>	<u>14'</u>
<u>P O Box 2208</u>	<u>Lime Clay</u>	<u>14'</u>	<u>86'</u>
<u>Columbus, MS 39701</u>	<u>1st Sand</u>	<u>86'</u>	<u>126'</u>
<u>(mailing address)</u>	<u>Muck</u>	<u>126'</u>	<u>156'</u>
<u>WELL LOCATION:</u>	<u>Water Sand</u>	<u>156'</u>	
<u>sec. 34 T 18 N R 18 E S W</u>			
<u>1</u> miles <u>South</u> of <u>Columbus</u>			
<u>(distance)</u> <u>(direction)</u> <u>(nearest town)</u>			
<u>WELL PURPOSE: Industry</u>			
<u>(home, irrigation, municipal, industrial)</u>			
<u>WELL COMPLETION DATA:</u>			
(1) diameter (inches) <u>4"</u>			
(2) total depth (feet) <u>346'</u>			
(3) static water level (feet) <u>50'</u> below top of ground.			
(4) casing <u>PVC</u> (material) <u>(depth)</u>			
<u>4" x 2"</u> if telescope see back. (size)			
(5) screen <u>60'</u> (length) <u>286'</u> (depth to top)			
<u>2"</u> (size) <u>PVC</u> (material)			
(6) pump <u>3/4</u> (HP) <u>13</u> (yield gpm)			
<u>Electric</u> (type power)			
(7) electric log <u>No</u> (yes or no)			
<u>capped</u> (organization running log)			
(8) how well bottom plugged _____			

DRILLERS REMARKS: _____


MISSISSIPPI DEPARTMENT OF NATURAL RESOURCES
 BUREAU OF LAND & WATER RESOURCES

DEC - 6 1984
 RECEIVED

If well telescopes please sketch and show depths.

GROUND LEVEL

122' 4" CASING

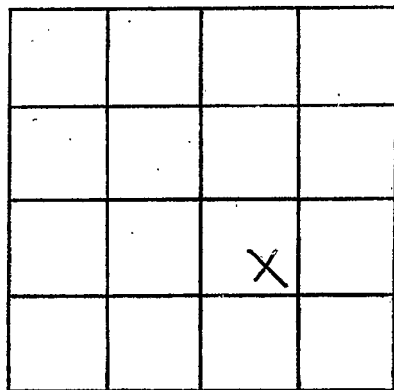

170' 2" CASING

SECTION 34

Please indicate well location X.

ADDITIONAL INFORMATION

60' Screen

If more than one screen, show locations of each on sketch.