

MISSISSIPPI DEPARTMENT OF NATURAL RESOURCES

Bureau of Land and Water Resources

Southport Mall

P.O. Box 10631

Jackson, Mississippi 39209

WATER WELL DRILLERS LOG

Louder
G
2093

5-22-84, 19 Clardy Well Drilling Louder
 date well completed firm name county well located

LANDOWNER: Bill Wharton
Hwy 50
Columbus, MS
 (mailing address)

WELL LOCATION:
 sec. 12 T. 18 N. R. 18 E.
in City of Col.
 miles (distance) of (direction) (nearest town)

WELL PURPOSE: Home
 (home, irrigation, municipal, industrial)

WELL COMPLETION DATA:

(1) diameter (inches) 4"

(2) total depth (feet) 150'

(3) static water level (feet) 15' below above top of ground.

(4) casing PVC, 83',
 (material) (depth)
 (size) if telescope see back.

(5) screen _____
 (length) (depth to top)
 (size) (material)

(6) pump 1/2 900 gph
 (HP) (yield gpm)
elec.
 (type power)

(7) electric log no
 (yes or no)
 (organization running log)

(8) how well bottom plugged _____


| description of formations encountered | from | to |
|---------------------------------------|---------|---------|
| Clay | 0 | 5 |
| sand & gravel | 5 | 29 |
| sandy clay | 29 | 70 |
| good clay | 70 | 74 |
| rocky | 74 | 78 |
| good clay | 78 | 89 |
| sandy clay | 89 | 100 |
| rock 3" | 100 | |
| brown clay | 100 | 109 1/2 |
| rock | 109 1/2 | 110 |
| brown sandy clay | 110 | 115 |
| hard brown clod. | 115 | 119 |
| sand | 119 | 129 |
| hard brown clay | 129 | 134 |
| good blue clay | 134 | 150 |

DRILLERS REMARKS:

DEPT. OF NATURAL RESOURCES
 BUREAU OF LAND & WATER RESOURCES
 RECEIVED
 JUL 2 1984

If well telescopes please sketch and show depths.

GROUND LEVEL

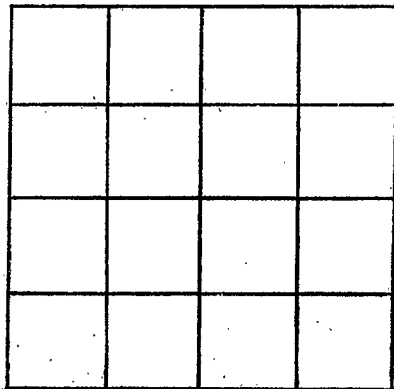

SECTION _____

Please indicate well location X.

ADDITIONAL INFORMATION

If more than one screen,
show locations of each on sketch.