

MISSISSIPPI DEPARTMENT OF NATURAL RESOURCES

Bureau of Land and Water Resources

Southport Mall

P.O. Box 10631

Jackson, Mississippi 39209

WATER WELL DRILLERS LOG

LOWNDES
R G
2094

6-28-84 date well completed
Clardy Well Drilling (firm name)
Lumberton county well located

LANDOWNER: Floyd Wayne
Spartline Rd.
Columbus, MS
(mailing address)

description of formations encountered	from	to
clay	0	14
sand	14	50
sandy clay	50	70
crad. clast	70	77 1/2
rock 2" Ø		
good clay	99 1/2	103
hard sand	103	119
sandy clay	119	122

WELL LOCATION:
sec. 3 T. 18 N. R. 18 E.
7 miles no of Coln.
(distance) (direction) (nearest town)

WELL PURPOSE:
(home, irrigation, municipal, industrial)

- WELL COMPLETION DATA:
- (1) diameter (inches) 4"
 - (2) total depth (feet) 122'
 - (3) static water level (feet) 25' below above top of ground.
 - (4) casing PVC, 93' (material) (depth)
4" (size) If telescope see back.
 - (5) screen 20' (length) (depth to top)
2" PVC (size) (material)
 - (6) pump 1/2 900 gph (HP) (yield gpm)
elec. (type power)
 - (7) electric log no (yes or no)
(organization running log)
 - (8) how well bottom plugged

DEPT. OF NATURAL RESOURCES
BUREAU OF LAND & WATER RESOURCES


JUL 11 1984

RECEIVED


DRILLERS REMARKS:
Spartline Rd.

If well telescopes please sketch and show depths.

GROUND LEVEL

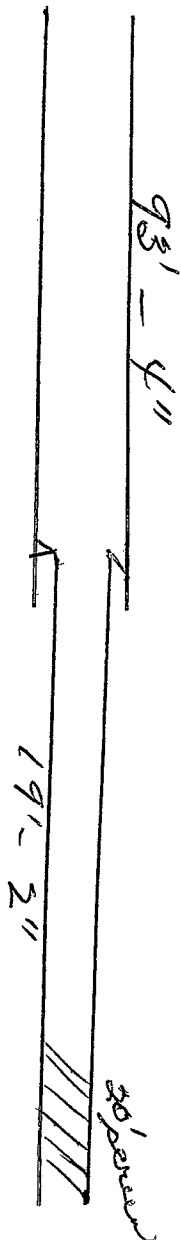

If more than one screen, show locations of each on sketch.

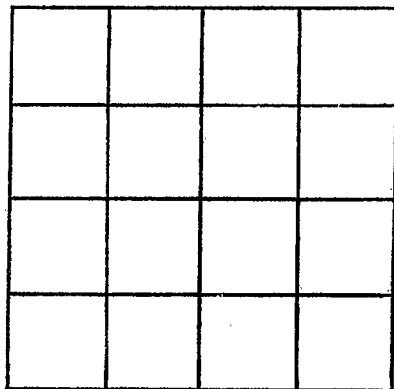

SECTION _____

Please indicate well location X.

ADDITIONAL INFORMATION

A series of horizontal lines for providing additional information.