

Lowndes
G
2095

MISSISSIPPI
 BOARD OF WATER COMMISSIONERS
 416 North State Street
 Jackson, Mississippi 39201

WATER WELL DRILLERS LOG

Sept 18 1984 Mid South Drilling Company Lowndes
 date well completed firm name county well located

LANDOWNER: <u>Floyd Bostick III</u> <u>Rt. 8 Box 138</u>	description of formations encountered	from	to
<u>Columbus, MS 39701</u> (mailing address)	clay	0	8
WELL LOCATION:	sand and gravel	8	31
sec. <u>35-18</u> S R <u>18</u> E <u>2</u> miles S of <u>Columbus</u> (distance) (direction) (nearest town)	clay	31	60
WELL PURPOSE: <u>home</u> (home, irrigation, municipal, industrial)	clay and sand	60	180
WELL COMPLETION DATA: (1) diameter (inches) <u>4"</u> (2) total depth (feet) <u>180'</u> (3) static water level (feet) <u>18'</u> <u>below</u> <u>above</u> top of ground. <u>XXXX</u> (4) casing <u>PVC</u> <u>120'</u> (material) (depth) <u>4"</u> (size) if telescope see back. (5) screen <u>none</u> (length) (depth to top) (size) (material) (6) pump <u>3/4</u> <u>10</u> (HP) (yield gpm) <u>electric</u> (type power) (7) electric log <u>no</u> (yes or no) <u>none</u> (organization running log) (8) how well bottom plugged <u>open</u>			


DRILLERS REMARKS:

DEPT. OF NATURAL RESOURCES
 BUREAU OF LAND & WATER RESOURCES

OCT 9 1984
 RECEIVED

If well telescopes please sketch and show depths.

GROUND LEVEL

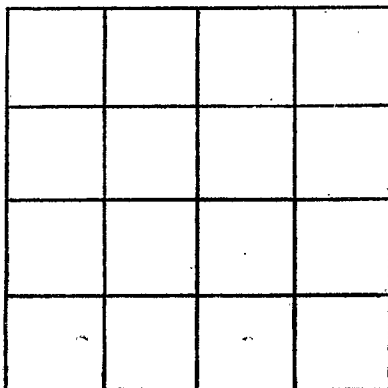

SECTION _____

Please indicate well location X.

ADDITIONAL INFORMATION

If more than one screen, show locations of each on sketch.