

Lowndes  
G  
2097

MISSISSIPPI DEPARTMENT OF NATURAL RESOURCES  
 Bureau of Land and Water Resources  
 Southport Mall  
 P.O. Box 10631  
 Jackson, Mississippi 39209  
**WATER WELL DRILLERS LOG**

11-26  
 date well completed

19 Clardy Well Drilling Lowndes  
 firm name county well located

LANDOWNER:  
Ruby Hinton  
Columbus, Miss  
 (mailing address)

WELL LOCATION:  
 sec. 29 T. 18 N. R. 18 W. Colo.  
1 miles (distance) W (direction) of (nearest town)

WELL PURPOSE:  
 (home, irrigation, municipal, industrial)

WELL COMPLETION DATA:

(1) diameter (inches) 4"

(2) total depth (feet) 233'

(3) static water level (feet) 25' below top of ground

(4) casing PVC (material) 160' (depth)  
4" (size) If telescope see back.

(5) screen \_\_\_\_\_ (length) \_\_\_\_\_ (depth to top)  
 (size) \_\_\_\_\_ (material)

(6) pump 1/2 (HP) 900 gph (yield gph)  
elec (type power)

(7) electric log no (yes or no)  
 (organization running log)

(8) how well bottom plugged \_\_\_\_\_


description of formations encountered	from	to
red clay	0	13
red sand gravel	13	57
sandy blue clay	57	94
hard clay	94	98
sandy clay	98	119
good clay	119	131
sandy clay	131	143
rock 6"	143	143 1/2
sandy clay	143 1/2	147 1/2
rock 6"		
sandy clay	143	155
good clay	155	190
good sand	190	209
clay	209	333

DRILLERS REMARKS:  
old Hwy 83 West

DEPT. OF NATURAL RESOURCES  
 BUREAU OF LAND & WATER RESOURCES  
 DEC 27 1984  
**RECEIVED**

If well telescopes please  
sketch and show depths.

GROUND LEVEL

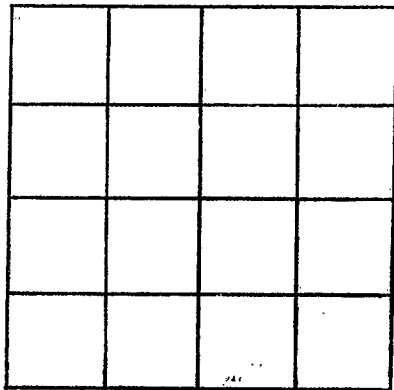

SECTION \_\_\_\_\_

Please indicate well location X.

ADDITIONAL INFORMATION

If more than one screen,  
show locations of each on sketch.

A handwritten scribble consisting of several connected loops, resembling a stylized 'M' or 'W'.