

Bunker  
G G  
2098

MISSISSIPPI  
 BOARD OF WATER COMMISSIONERS  
 416 North State Street  
 Jackson, Mississippi 39201  
 WATER WELL DRILLERS LOG

11-30-84 19 Mid South Drilling Company Lowndes  
 date well completed firm name county well located

LANDOWNER: Contractor	description of formations encountered	from	to
O.C. ELECTRIC 2002 4th Ave. North Columbus, MS 39701 (mailing address)			
	sand and gravel	8	32
	clay and sand	32	195

WELL LOCATION:  
 sec. 13 T 18 S R 18 E  
in miles city of limits  
 (distance) (direction) (nearest town)

WELL PURPOSE: home  
 (home, irrigation, municipal, industrial)

WELL COMPLETION DATA:

(1) diameter (inches) 4"

(2) total depth (feet) 195'

(3) static water level (feet) \_\_\_\_\_ below  
 top of ground. above

(4) casing PVC 60'  
 (material) (depth)  
4"  
 (size) if telescope see back.

(5) screen none  
 (length) (depth to top)  
 (size) (material)

(6) pump none  
 (HP) (yield-gpm)  
 (type power)

(7) electric log no  
 (yes or no)  
no  
 (organization running log)


(8) how well bottom plugged open

1-21-85  
JW

DRILLERS REMARKS:

If well telescopes please sketch and show depths.

GROUND LEVEL

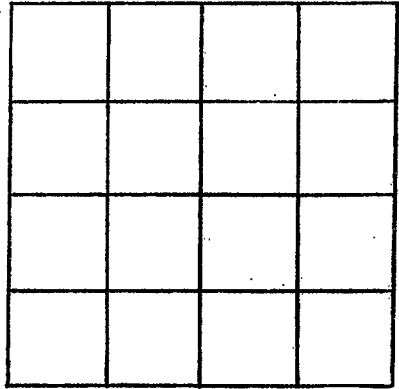

SECTION \_\_\_\_\_

Please indicate well location X.

ADDITIONAL INFORMATION

If more than one screen, show locations of each on sketch.