

MISSISSIPPI DEPARTMENT OF NATURAL RESOURCES
Bureau of Land and Water Resources
 Southport Mall
 P.O. Box 10631
 Jackson, Mississippi 39209
WATER WELL DRILLERS LOG

Lowndes
G
2100

1-11 1988 Clardy Well Drilling Lowndes
 date well completed firm name county well located

LANDOWNER: Arline Adams
Highway 82 W.
Columbus, MS
 (mailing address)

WELL LOCATION:
 sec. 24 T. 18 N R. 18 E
3 miles W of Cols.
 (distance) (direction) (nearest town)

WELL PURPOSE: home
 (home, irrigation, municipal, industrial)

WELL COMPLETION DATA:

(1) diameter (inches) 4"

(2) total depth (feet) 242'

(3) static water level (feet) _____ below above top of ground.

(4) casing PVC, 81'
 (material) (depth)
 _____ if telescope see back.
 (size)

(5) screen _____
 (length) (depth to top)

 (size) (material)

(6) pump 1/2 900 gph
 (HP) (yield gpm)

elec.
 (type power)

(7) electric log no
 (yes or no)

 (organization running log)

(8) how well bottom plugged _____

description of formations encountered	from	to
brown clay	0	16
blue clay	16	24
sand & gravel	24	49
sandy clay	44	75
rock clay	75	82
sandy clay	82	135
rock 2"	135	
sandy clay	135	158
sand	158	164
sandy clay	164	211
rocky	211	214
sand	214	240
rock 6"	240	240 1/2
mud	240 1/2	242


RECEIVED
 MAR 4 - 1988

Department of Natural Resources
 Bureau of Land & Water Resources

DRILLERS REMARKS: _____

If well telescopes please
sketch and show depths.

GROUND LEVEL

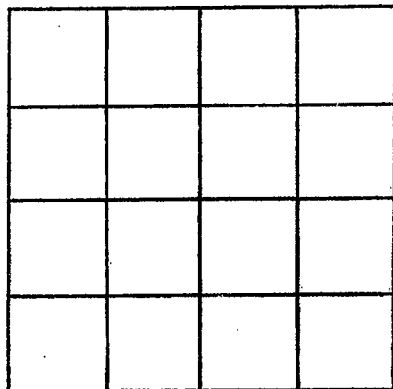

SECTION _____

Please indicate well location X.

ADDITIONAL INFORMATION

If more than one screen,
show locations of each on sketch.