

MISSISSIPPI DEPARTMENT OF NATURAL RESOURCES
Bureau of Land and Water Resources
 Southport Mall
 P.O. Box 10631
 Jackson, Mississippi 39209
WATER WELL DRILLERS LOG

Lowndes
G 2101
~~_____~~

1-18 - 85 Clardy Well Drilling Lowndes
 date well completed firm name county well located

LANDOWNER: Clair Rice
Hwy 82 W.
Columbus, Ms.
 (mailing address)

WELL LOCATION:
 sec 34 T 18 N R 18 E
3 miles W of Colo.
 (distance) (direction) (nearest town)

WELL PURPOSE: home
 (home, irrigation, municipal, industrial)

- WELL COMPLETION DATA:
- (1) diameter (inches) 4"
 - (2) total depth (feet) 242
 - (3) static water level (feet) 32' below top of ground.
 - (4) casing Pvc, 81'
 (material) (depth)
4"
 (size) if telescope see back.
 - (5) screen _____
 (length) (depth to top)
 (size) (material)
 - (6) pump 1/2 900 gph
 (HP) (yield gpm)
 - (7) electric log no
 (yes or no)
 (organization running log) _____
 - (8) how well bottom plugged _____

description of formations encountered	from	to
red clay	0	14
sand gravel	14	49
sandy clay	49	75
good clay	75	86
sandy clay	86	124
good clay	124	133
sandy clay	133	153
sand	153	163
sandy clay	163	217
sand	217	233
rock	233	232 1/2
sand	232 1/2	242


RECEIVED
 MAR 4 - 1985

Department of Natural Resources
 Bureau of Land & Water Resources

DRILLERS REMARKS:

If well telescopes please sketch and show depths.

GROUND LEVEL

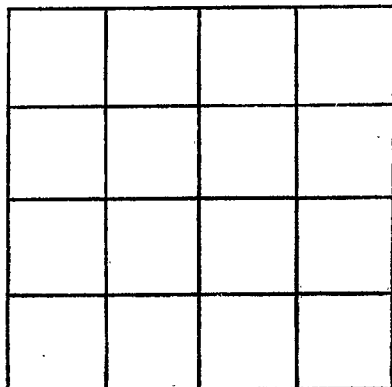

SECTION _____

Please indicate well location X.

ADDITIONAL INFORMATION

If more than one screen, show locations of each on sketch.