

MISSISSIPPI DEPARTMENT OF NATURAL RESOURCES

Bureau of Land and Water Resources

Southport Mall

P.O. Box 10631

Jackson, Mississippi 39209

WATER WELL DRILLERS LOG

Louder  
G2102

1-25-85  
date well completed

Lardy Well Drilling Louder  
firm name county well located

LANDOWNER: Joe Webb  
 Hwy 82 W.  
 Columbus, MS.  
(mailing address)

WELL LOCATION:  
sec. 34 T. 18 N. R. 78 E  
2 miles W of Colo.  
(distance) (direction) (nearest town)

WELL PURPOSE: home  
(home, irrigation, municipal, industrial)

WELL COMPLETION DATA:

description of formations encountered	from	to
sand	0	12
sand & gravel	12	48
sandy clay	48	74
good clay	74	80
sandy clay	80	123
good clay	123	130
sandy clay	130	192
sand	192	205
sandy clay	205	222
rock 3"		
sandy clay	222	223
good sand	223	242

(1) diameter (inches) 4"

(2) total depth (feet) 242'

(3) static water level (feet) 23' below top of ground.

(4) casing Pvc, 81'  
(material) (depth)

4" if telescope see back.  
(size)

(5) screen (length) (depth to top)

(size) (material)  
(6) pump 1/2 900gph  
(HP) (yield gpm)

elec  
(type power)

(7) electric log no  
(yes or no)

(organization running log)

(8) how well bottom plugged


DRILLERS REMARKS:

RECEIVED  
MAR 4 - 1985

Department of Natural Resources  
Bureau of Land & Water Resources

If well telescopes please sketch and show depths.

GROUND LEVEL

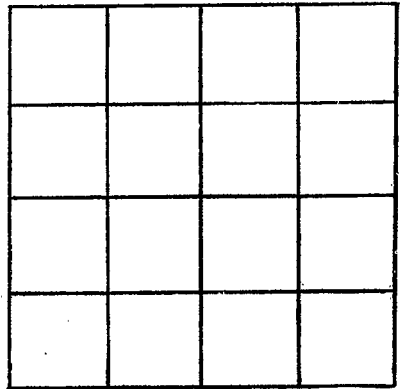

SECTION \_\_\_\_\_

Please indicate well location X.

ADDITIONAL INFORMATION

If more than one screen,  
show locations of each on sketch.