

Lowndes  
G 2103  
4-12-85

MISSISSIPPI DEPARTMENT OF NATURAL RESOURCES  
 Bureau of Land and Water Resources  
 Southport Mall  
 P.O. Box 10631  
 Jackson, Mississippi 39209  
**WATER WELL DRILLERS LOG**

April 12, 1985 Mid South Drilling Company Lowndes  
 date well completed firm name county well located


**LANDOWNER: Contractor**  
 O. C. Electric  
 2002 4th Ave. North  
 Columbus, MS 39701  
 (mailing address)

**WELL LOCATION:**  
 sec. 7 T. 18 S. R. 18 W.  
1 miles W of Columbus  
 (distance) (direction) (nearest town)

**WELL PURPOSE:** home  
 (home, irrigation, municipal, industrial)

- WELL COMPLETION DATA:**
- (1) diameter (inches) 4"
  - (2) total depth (feet) 285'
  - (3) static water level (feet) 30' ~~above~~ below  
 top of ground. ~~XXXX~~
  - (4) casing PVC 120'  
 (material) (depth)  
4"  
 (size) if telescope see back.
  - (5) screen none  
 (length) (depth to top)  
 (size) (material)
  - (6) pump none  
 (HP) (yield gpm)  
 (type power)
  - (7) electric log no  
 (yes or no)  
none  
 (organization running log)
  - (8) how well bottom plugged open

description of formations encountered	from	to
clay	0	11
sand and gravel	11	30
clay	30	75
clay and sand	75	150
sand	150	168
clay and sand	168	285

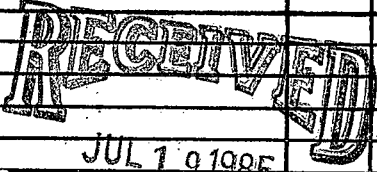


JUL 19 1985

**DRILLERS REMARKS:**

Department of Natural Resources  
 Bureau of Land & Water Resources

If well telescopes please  
sketch and show depths.

GROUND LEVEL

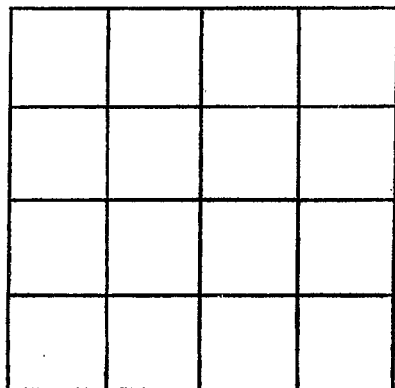

SECTION \_\_\_\_\_

Please indicate well location X.

ADDITIONAL INFORMATION

If more than one screen,  
show locations of each on sketch.