

MISSISSIPPI DEPARTMENT OF NATURAL RESOURCES

Bureau of Land and Water Resources

Southport Mall

P.O. Box 10631

Jackson, Mississippi 39209

WATER WELL DRILLERS LOG

LOWNDES

G. 2104

5-3-85
date well completed

19 Clardy Well Drilling Lowndes
firm name county well located

LANDOWNER: John Gore
Yorkville Rd.
Cols. Ms.
(mailing address)

WELL LOCATION:
sec 23 T 18 N R 18 E
1/2 miles S of Cols.
(distance) (direction) (nearest town)

WELL PURPOSE: home
(home, irrigation, municipal, industrial)

WELL COMPLETION DATA:

(1) diameter (inches) 4"

(2) total depth (feet) 246 1/2

(3) static water level (feet) 30' below above top of ground.

(4) casing PVC 93'
(material) (depth)
4" if telescope see back.
(size)

(5) screen _____
(length) (depth to top)
(size) _____ (material)

(6) pump 1/2 _____
(HP) (yield gpm)
elec
(type power)

(7) electric log no
(original station running log)

(8) how well bottom plugged
WIN 21 1985


description of formations encountered	from	to
red. sandy clay	0	8
gravel	8	13
blue clay	13	65
sandy clay	65	121
clay	121	125
sandy streak	125	129
sandy clay	129	133
sandy streak	133	136
sandy clay	136	141
rock 4"		
sandy clay	141	145
rock 6"	145	145 1/2
sandy clay	145 1/2	159
rock 2"		
rock 2"	159 1/2	
clay	162	
rock 1"	162	165 1/2
clay	165 1/2	
rock 1"	165 1/2	169
clay	169	
rock 6"	169	170 1/2
clay	171	
rock 2"	171	173 1/2
clay	173 1/2	
rock 1"	173 1/2	177
sandy clay	177	188
sand	188	188 1/2
fine sandy clay	188 1/2	205
fsand	205	205 1/2
fine sandy clay	205 1/2	207 1/2
rock 1"		
sandy clay	207 1/2	209
sand	209	212
fine sandy clay	212	227
fsand	227	231
sh. rock		
clay	231	239
sand	239	242
soft sandy clay	242	246 1/2

RECEIVED

DEPARTMENT OF NATURAL RESOURCES
BUREAU OF LAND AND WATER RESOURCES

If well telescopes please sketch and show depths.

GROUND LEVEL

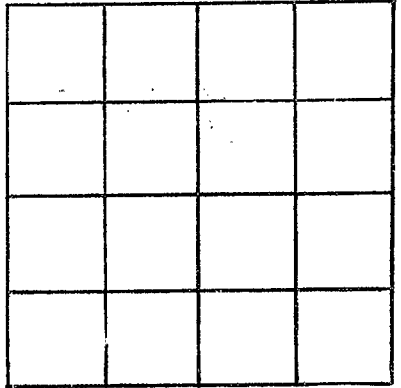

SECTION _____

Please indicate well location X.

ADDITIONAL INFORMATION

If more than one screen,
show locations of each on sketch.