

MISSISSIPPI DEPARTMENT OF NATURAL RESOURCES

Bureau of Land and Water Resources

Southport Mall

P.O. Box 10631

Jackson, Mississippi 39209

WATER WELL DRILLERS LOG

LOWNDES

G 2105

5-8-85
date well completed

Clardy Well Drilling LOWNDES
firm name county well located

LANDOWNER: Betty Lathaw

727 15th St. No.

Columbus, Miss.
(mailing address)

WELL LOCATION:

sec. 35 T 18 N R 18 E
2 miles S of Col.
(distance) (direction) (nearest town)

WELL PURPOSE: home
(home, irrigation, municipal, industrial)

WELL COMPLETION DATA:

- (1) diameter (inches) 4"
- (2) total depth (feet) 193 1/2'
- (3) static water level (feet) 16' below above-top of ground.
- (4) casing PVC, 81
(material) (depth)
4"
(size) if telescope see back.
- (5) screen _____
(length) (depth to top)
(size) (material)
- (6) pump 1/2 900 gph.
(HP) (yield gpm)
elec.
(type power)
- (7) electric log no
(yes or no)

(organization running log)

(8) how well bottom plugged _____

DRILLERS REMARKS:

description of formations encountered

from

to

<u>Sandy white & red Clay</u>	<u>0</u>	<u>16</u>
<u>Sandy blue Clay</u>	<u>16</u>	<u>55</u>
<u>Silt Clay</u>	<u>55</u>	<u>58</u>
<u>Sandy Clay</u>	<u>58</u>	<u>73</u>
<u>rock</u>	<u>73 1/2</u>	<u>74 1/2</u>
<u>good Clay</u>	<u>74 1/2</u>	<u>74 1/2</u>
<u>Sm. rock</u>		
<u>Clay</u>	<u>77 1/2</u>	<u>78 1/2</u>
<u>Sandy streaks</u>	<u>78 1/2</u>	<u>101</u>
<u>Clay</u>	<u>101</u>	<u>103</u>
<u>soft sandy Clay</u>	<u>103</u>	<u>130 1/2</u>
<u>Sm. rock</u>		
<u>good Clay</u>	<u>130 1/2</u>	<u>137</u>
<u>Sandy Clay</u>	<u>137</u>	<u>141</u>
<u>" "</u>		<u>143</u>
<u>sand</u>	<u>143</u>	<u>148</u>
<u>rock 2"</u>	<u>148</u>	
<u>Sandy streak</u>	<u>148</u>	<u>157</u>
<u>soft sandy Clay</u>	<u>157</u>	<u>169</u>
<u>sand</u>	<u>169</u>	<u>171</u>
<u>soft sandy Clay</u>	<u>171</u>	<u>176 1/2</u>
<u>rock 2"</u>		
<u>soft sandy Clay</u>	<u>176 1/2</u>	<u>178</u>
<u>Sandy streak</u>	<u>178</u>	<u>181</u>
<u>soft sandy Clay</u>	<u>181</u>	<u>184</u>
<u>rock 1"</u>	<u>184</u>	
<u>rock 1"</u>	<u>184 1/2</u>	
<u>rock 1"</u>	<u>190 1/2</u>	
<u>rock</u>	<u>193 1/2</u>	


RECEIVED

JUN 21 1985

Department of Natural Resources
Bureau of Land & Water Resources

If well telescopes please sketch and show depths.

GROUND LEVEL

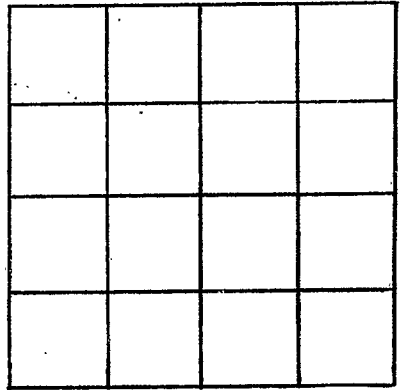

SECTION _____

Please indicate well location X.

ADDITIONAL INFORMATION

If more than one screen,
show locations of each on sketch.