

MISSISSIPPI DEPARTMENT OF NATURAL RESOURCES

Bureau of Land and Water Resources

Southport Mall

P.O. Box 10631

Jackson, Mississippi 39209

WATER WELL DRILLERS LOG

Lowndes  
G 2106  
6-20-85

6-20-85 date well completed  
Clardy Well Drilling firm name  
Lowndes county well located

LANDOWNER: J. L. Granderson  
Old Pickensville Rd.  
Columbus, Miss.  
(mailing address)

WELL LOCATION:  
sec. 35 T 18 N R 18 E W 6  
3 miles So of Calo.  
(distance) (direction) (nearest town)

WELL PURPOSE: home  
(home, irrigation, municipal, industrial)

WELL COMPLETION DATA:

(1) diameter (inches) 4"

(2) total depth (feet) 182'

(3) static water level (feet) 40' below top of ground.

(4) casing PVC, 95'  
(material) (depth)

(size) If telescope see back.

(5) screen (length) (depth to top)

(size) (material)

(6) pump 1/2 850 gph  
(HP) (yield gph)

elec  
(type power)

(7) electric log no  
(yes or no)

(organization running log)

(8) how well bottom plugged

description of formations encountered	from	to
Clay	0	8
gravel & sand	8	23
brown clay	23	24
blue clay	24	60
sandy clay	60	83
rocky blue clay	83	88 1/2
blue clay	88 1/2	90
soft blue clay	90	100
blue clay	100	135
sandy clay	135	138
hard clay	138	148
sand	148	155
rocky	155	157
sandy	157	176
good sand	176	182


RECEIVED  
AUG - 2 1985

DRILLERS REMARKS:

Department of Natural Resources  
Bureau of Land & Water Resources

If well telescopes please sketch and show depths.

GROUND LEVEL

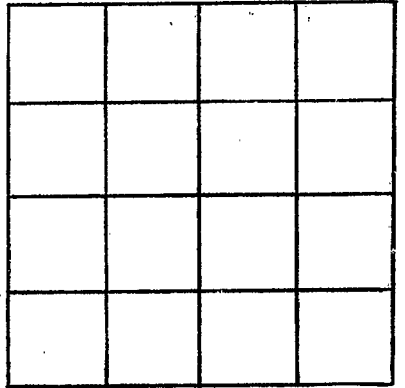

SECTION \_\_\_\_\_

Please indicate well location X.

ADDITIONAL INFORMATION

If more than one screen,  
show locations of each on sketch.