

MISSISSIPPI DEPARTMENT OF NATURAL RESOURCES

Bureau of Land and Water Resources

Southport Mall

P.O. Box 10631

Jackson, Mississippi 39209

WATER WELL DRILLERS LOG

G-2108  
Lowndes

9-16-85  
 date well completed

Clardy Well Drilling Lowndes  
 firm name county well located

LANDOWNER: William Murray  
Hwy 69  
Columbus, Ms.  
 (mailing address)

WELL LOCATION:  
 sec. 26 T 18 N R 18 E  
1 miles S of Colo.  
 (distance) (direction) (nearest town)

WELL PURPOSE: home  
 (home, irrigation, municipal, industrial)

- WELL COMPLETION DATA:
- (1) diameter (inches) 4"
  - (2) total depth (feet) 182'
  - (3) static water level (feet) 18' below top of ground.
  - (4) casing Pvc, 89'-6"  
 (material) (depth)  
4" if telescope see back.  
 (size)
  - (5) screen \_\_\_\_\_  
 (length) (depth to top)  
 (size) (material)
  - (6) pump 1/2 850 gpm  
 (HP) (yield gpm)  
elec  
 (type power)
  - (7) electric log no  
 (yes or no)  
 (organization running log)
  - (8) how well bottom plugged \_\_\_\_\_

description of formations encountered	from	to
Clay	0	9
gravel	9	22
Clay	23	31
sand	31	35
sandy clay	35	37
soft blue clay	37	37
blue clay	37	110
good blue clay	110	134
sand	134	141 1/2
sandy clay	141 1/2	149
sand	149	154
Clay	154	176
rock	176	
Clay	176	182

RECEIVED


NOV - 4 1985

DRILLERS REMARKS:

Department of Natural Resources  
 Bureau of Land & Water Resources

If well telescopes please sketch and show depths.

GROUND LEVEL

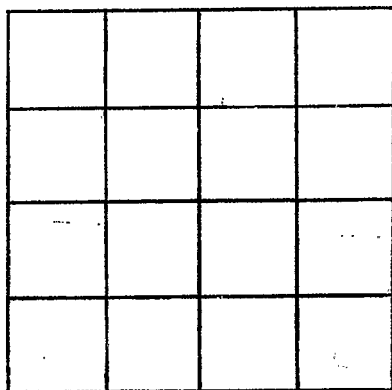

SECTION \_\_\_\_\_

Please indicate well location X.

ADDITIONAL INFORMATION

If more than one screen,  
show locations of each on sketch.