

MISSISSIPPI DEPARTMENT OF NATURAL RESOURCES

Bureau of Land and Water Resources

Southport Mall

P.O. Box 10631


Jackson, Mississippi 39209

WATER WELL DRILLERS LOG

LOWNDES
G
2110

May 23 19 86 Mid South Drilling Company Lowndes
 date well completed firm name county well located

LANDOWNER: Jeffery Steel O. C. Electirc 2002 4th Ave. North Columbus, MS 39701 (mailing address)	description of formations encountered	from	to
WELL LOCATION: sec. 29 T 18SN S R 14WE W miles in Columbus (distance) (direction) (nearest town) WELL PURPOSE: business (home, irrigation, municipal, industrial) WELL COMPLETION DATA: (1) diameter (inches) 4 (2) total depth (feet) 230 (3) static water level (feet) 32 below top of ground. (4) casing PVC, 120' (material) (depth), 4" (size) if telescope see back. (5) screen none (length) (depth to top) (size) (material) (6) pump none (HP) (yield gpm) (type power) (7) electric log no (yes or no) none (organization running log) (8) how well bottom plugged open	sand and gravel	0	5
	sand	5	10
	clay	10	15
	sand and gravel	15	20
	clay	20	105
	clay and sand	105	120
	clay	120	140
	sand	140	158
	clay	158	175
	sand	175	200
clay	200	205	
sand	205	225	
clay	225	230½	

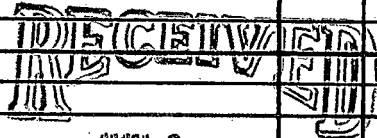


JUN 05 1986

Department of Natural Resources
 Bureau of Land & Water Resources

DRILLERS REMARKS:

If well telescopes please sketch and show depths.

GROUND LEVEL

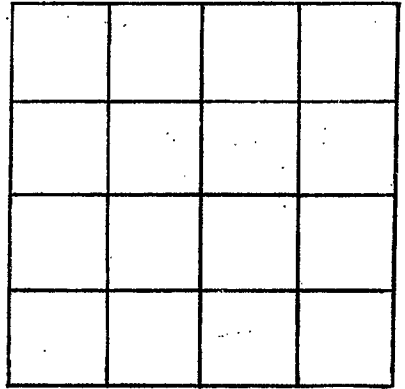

SECTION _____

Please indicate well location X.

ADDITIONAL INFORMATION

If more than one screen,
show locations of each on sketch.