

LOWNDES  
G  
2111

MISSISSIPPI DEPARTMENT OF NATURAL RESOURCES  
Bureau of Land and Water Resources  
Southport Mall  
P.O. Box 10631  
Jackson, Mississippi 39209  
WATER WELL DRILLERS LOG

7/2/86 19 Clardy Well Drilling Lowndes  
date well completed firm name county well located

LANDOWNER: Providence  
Missionary Baptist Ch.  
Rt 8  
Columbus, Ms.  
(mailing address)

description of formations encountered	from	to
sand & gravel	5	21
blue clay	21	91
sandy clay	91	98
hard blue clay	98	105
sandy clay	105	124
hard clay	124	137
sandy clay	137	144
rocky	144	151
sandy clay	151	156
sand	156	178
rock	178	178 1/2
clay	178 1/2	182

WELL LOCATION:  
sec. 34 T. 18 N. R. 18 E.  
1 1/2 miles So of Colo.  
(distance) (direction) (nearest town)

WELL PURPOSE: Church  
(home, irrigation, municipal, industrial)

WELL COMPLETION DATA:

- (1) diameter (inches) 4"
- (2) total depth (feet) 182'
- (3) static water level (feet) 18' below top of ground.
- (4) casing Pvc, 82' (material), (depth)  
4" (size) if telescope see back.
- (5) screen \_\_\_\_\_ (length) \_\_\_\_\_ (depth to top)  
(size) \_\_\_\_\_ (material)
- (6) pump \_\_\_\_\_ (HP) \_\_\_\_\_ (yield gpm)  
(type power)
- (7) electric log \_\_\_\_\_ (yes or no)  
(organization running log)
- (8) how well bottom plugged \_\_\_\_\_


RECEIVED  
SEP 09 1986

Department of Natural Resources  
Bureau of Land & Water Resources

DRILLERS REMARKS: \_\_\_\_\_

If well telescopes please sketch and show depths.

GROUND LEVEL

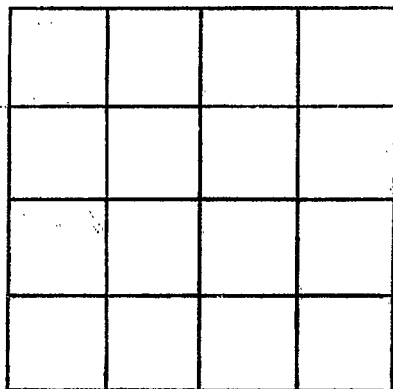

SECTION \_\_\_\_\_

Please indicate well location X.

ADDITIONAL INFORMATION

If more than one screen,  
show locations of each on sketch.