

LOWNDES
G
2113

MISSISSIPPI DEPARTMENT OF NATURAL RESOURCES
 Bureau of Land and Water Resources
 Southport Mall
 P.O. Box 10631
 Jackson, Mississippi 39209
WATER WELL DRILLERS LOG

6/20/86 19 Clardy Well Drilling Lowndes
 date well completed firm name county well located


LANDOWNER: Dandi T. Mullin
Rt 12 Box 36A
Columbus, MS.
 (mailing address)

WELL LOCATION:
 sec 25 T 18 N R 18 E
1 1/2 miles So. of Cela.
 (distance) (direction) (nearest town)

WELL PURPOSE: home
 (home, irrigation, municipal, industrial)

- WELL COMPLETION DATA:
- (1) diameter (inches) 4"
 - (2) total depth (feet) 142'
 - (3) static water level (feet) 22' below above top of ground.
 - (4) casing Pvc 100'
 (material) (depth)
4"
 (size) If telescope see back.
 - (5) screen _____
 (length) (depth to top)
 (size) (material)
 - (6) pump _____
 (HP) (yield gpm)
 (type power)
 - (7) electric log no
 (yes or no)
 (organization running log)
 - (8) how well bottom plugged _____

description of formations encountered	from	to
sand & gravel	5	29
sandy clay	29	46
good clay	46	71
rock	71	71 1/2
rock	71 1/2	80
good clay	80	92
sandy clay	92	95
good clay	95	130
good sand	130	139
blue clay	139	142

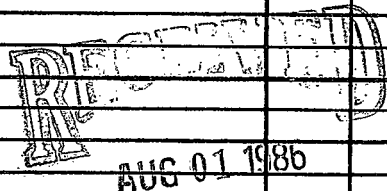


Department of Natural Resources
 Bureau of Land and Water Resources

DRILLERS REMARKS:

If well telescopes please sketch and show depths.

GROUND LEVEL

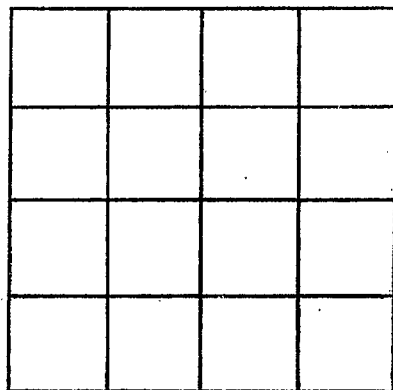

SECTION _____

Please indicate well location X.

ADDITIONAL INFORMATION

If more than one screen,
show locations of each on sketch.