

MISSISSIPPI DEPARTMENT OF NATURAL RESOURCES

Bureau of Land and Water Resources

Southport Mall

P.O. Box 10631

Jackson, Mississippi 39209

WATER WELL DRILLERS LOG

LOWNDES
G
2114

7/16/86 date well completed
 Clardy Well Drilling Lowndes firm name
 county well located

LANDOWNER: Mickey Liggins
Rt. 1
Caledonia, MS
 (mailing address)


description of formations encountered	from	to
Sand & Gravel	16	31
Sandy Clay	31	65
Thin Clay	65	76
rock	76	76 1/2
sandy clay	76 1/2	114
sand	114	134
Clay	134	134 1/2

WELL LOCATION:
 sec. 5 T. 18 N. R. 18 E. W. 5
1 miles (distance) W (direction) of Colo. (nearest town)

WELL PURPOSE: But Shop
 (home, irrigation, municipal, industrial)

- WELL COMPLETION DATA:
- (1) diameter (inches) 4"
 - (2) total depth (feet) 134 1/2
 - (3) static water level (feet) 12 below above top of ground.
 - (4) casing PVC 75' (material) (depth)
4" (size) if telescope see back.
 - (5) screen _____ (length) _____ (depth to top)
 (size) _____ (material)
 - (6) pump 1/2 900 gph (HP) (yield gpm)
elec (type power)
 - (7) electric log no (yes or no)
 _____ (organization running log)
 - (8) how well bottom plugged _____

DRILLERS REMARKS:

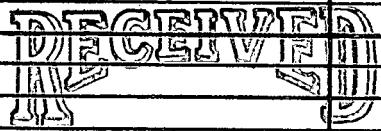


SEP 03 1986

Department of Natural Resources
 Bureau of Land & Water Resources

If well telescopes please sketch and show depths.

GROUND LEVEL

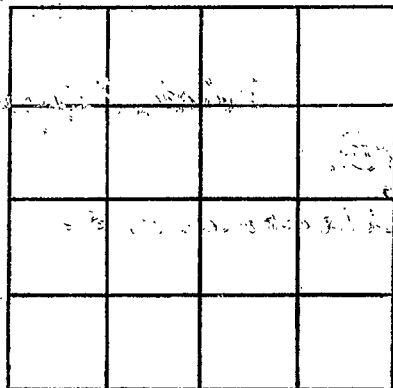

SECTION _____

Please indicate well location X.

ADDITIONAL INFORMATION

If more than one screen, show locations of each on sketch.