

MISSISSIPPI DEPARTMENT OF NATURAL RESOURCES

Bureau of Land and Water Resources

Southport Mall

P.O. Box 10631

Jackson, Mississippi 39209

WATER WELL DRILLERS LOG

LOWNDOS
G 2119

10-14-86
date well completed

19 Clardy Well Drilling
firm name

Lowndes
county well located

LANDOWNER: Albert Swartz

Hwy. 50

Columbus, Miss.
(mailing address)

WELL LOCATION:

sec. 2 T 18 N R 18 E
miles W of Colo.
(distance) (direction) (nearest town)

WELL PURPOSE: Camp ground
(home, irrigation, municipal, industrial)

WELL COMPLETION DATA:

- (1) diameter (inches) 4"
- (2) total depth (feet) 154'
- (3) static water level (feet) 12' below top of ground.
- (4) casing PVC, 75' (material) (depth), 4" (size) if telescope see back.
- (5) screen 30' (length) (depth to top), 2" PVC (size) (material)
- (6) pump 1/2 HP, 950 gph. (HP) (yield gpm), elec. (type power)
- (7) electric log no (yes or no)

(organization running log)

(8) how well bottom plugged

DRILLERS REMARKS:

description of formations encountered

from

to

Sand	0	17
Sand & gravel	17	23
good vlay	23	52
sandy clay	52	71
rock	71	72
good clay	72	77 1/2
rock	77 1/2	78
clay	78	78 1/2
rock (2")		
good clay	78 1/2	96
sandy clay	96	98
good clay	98	114
sand	114	117
good clay	117	121
sand	121	129
good clay	129	138
sand	138	154


RECEIVED

DEC 01 1986

Department of Natural Resources
Bureau of Land & Water Resources

If well telescopes please sketch and show depths.

GROUND LEVEL

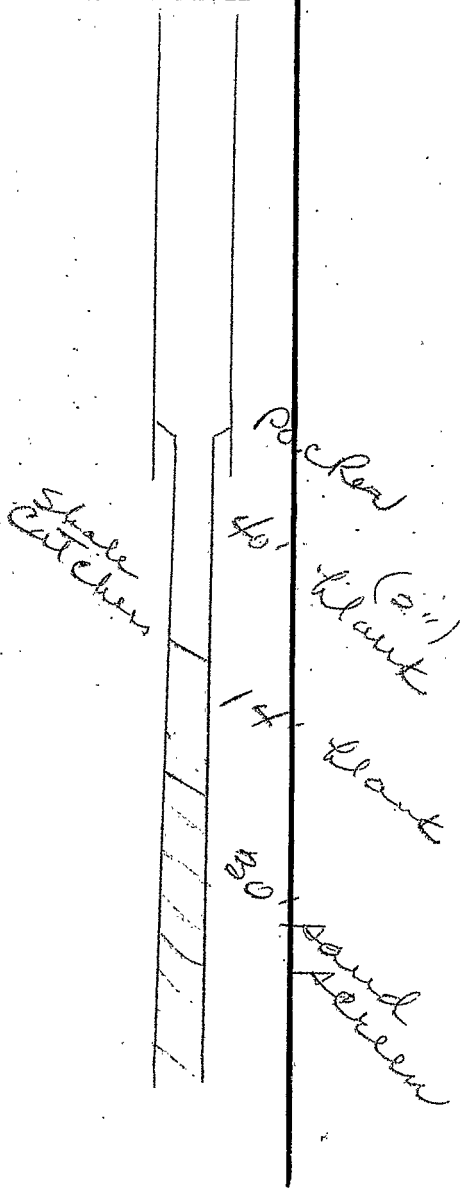

SECTION _____

Please indicate well location X.

ADDITIONAL INFORMATION

If more than one screen, show locations of each on sketch.