

MISSISSIPPI DEPARTMENT OF NATURAL RESOURCES

Bureau of Land and Water Resources

Southport Mall

P.O. Box 10631

Jackson, Mississippi 39209

WATER WELL DRILLERS LOG

LOWNDES
G 2120

4-13-87

19 Mid South Drilling Company

Lowndes

date well completed

firm name

county well located

LANDOWNER: Annie Smith
810 Shiloh Drive
Columbus, MS 39701
(mailing address)

WELL LOCATION:
sec. 2 T. 18 S. R. 18 E. W
1/4 miles east of Columbus
(distance) (direction) (nearest town)

WELL PURPOSE: home
(home, irrigation, municipal, industrial)

WELL COMPLETION DATA:

- (1) diameter (inches) 4
- (2) total depth (feet) 180
- (3) static water level (feet) 15 below top of ground. ~~XXXXXX~~
- (4) casing PVC 107'
(material) (depth)
4" if telescope see back.
(size)
- (5) screen none
(length) (depth to top)
(size) (material)
- (6) pump 1/2 10
(HP) (yield gpm)
electric
(type power)
- (7) electric log no
(yes or no)
none
(organization running log)
- (8) how well bottom plugged open

description of formations encountered	from	to
sand	0	5
gravel	5	14
clay	14	17
sand	17	25
clay	25	35
sand	35	42
clay	42	63
sand	63	66
clay	66	70
sand	70	72
clay	72	80
sand w/ clay streaks	80	90
sand	90	100
clay	100	122
sand	122	148
clay	148	151
sand	151	156
xxx clay w/ sand streak	156	167
xxx clay	167	169
sand	169	175
clay	175	180

rock at 75, 86, 103

RECEIVED


APR 20 1987

Department of Natural Resources
Bureau of Land & Water Resources

DRILLERS REMARKS:

If well telescopes please sketch and show depths.

GROUND LEVEL

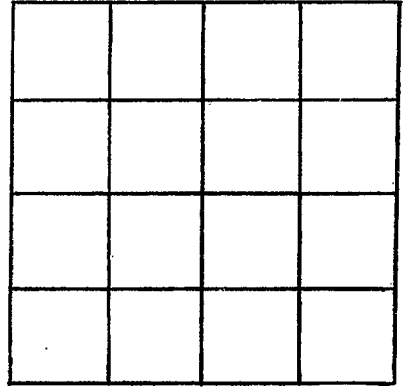

SECTION _____

Please indicate well location X.

ADDITIONAL INFORMATION

If more than one screen, show locations of each on sketch.