

MISSISSIPPI DEPARTMENT OF NATURAL RESOURCES
Bureau of Land and Water Resources
 Southport Mall
 P.O. Box 10631
 Jackson, Mississippi 39209
WATER WELL DRILLERS LOG

LOWNDES
G 2123

December 15 1986 Mid South Drilling Company Lowndes
 date well completed firm name county well located

LANDOWNER: Herod Granderson
 Rt. 8 Box 122
 Columbus, MS 39701
 (mailing address)

description of formations encountered	from	to
clay	0	6
sand & gravel	6	23
XX clay	23	68
sand	68	74
clay	74	80
clay & sand	80	180

WELL LOCATION:
 sec. 23 T. 18 N. R. 18 E.
 S W
 2 miles South of Columbus
 (distance) (direction) (nearest town)

WELL PURPOSE: house
 (home, irrigation, municipal, industrial)

- WELL COMPLETION DATA:**
- (1) diameter (inches) 4"
 - (2) total depth (feet) 180'
 - (3) static water level (feet) 20. ~~XXXX~~ below top of ground.
 - (4) casing PVC, 100' (material) (depth)
 4" (size) if telescope see back.
 - (5) screen none (length) (depth to top)
 (size) (material)
 - (6) pump none (HP) (yield gpm)
 (type power)
 - (7) electric log no (yes or no)
 no (organization running log)
 - (8) how well bottom plugged open

RECEIVED


JAN 16 1987

Department of Natural Resources
 Bureau of Land & Water Resources

DRILLERS REMARKS:

If well telescopes please
sketch and show depths.

GROUND LEVEL

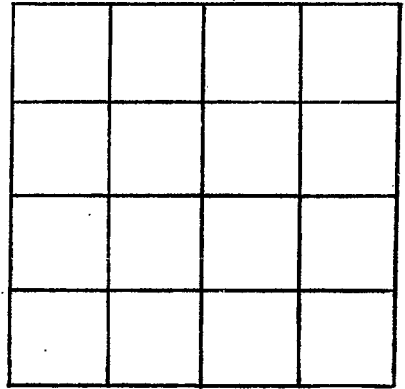

SECTION _____

Please indicate well location X.

ADDITIONAL INFORMATION

If more than one screen,
show locations of each on sketch.